

National Grid SA-COA

PRODUCTION FILE

Contractor : ABB Contracting Co.

Project : SS 8709- 132/13.8kV in Alkharj City

Contract No : 11131113/00

Substation : 8709

**Subject : 132Kv Busbar Protection Set-1 (+BBP1-1)
Relay Panel-1**





POWER SYSTEMS NETWORK MANAGEMENT
PROTECTION AND SUBSTATION AUTOMATION SYSTEMS
WBS NO: S-13656

ABB AUTOMATION COMPANY LTD.,
414, AL-KHARJ ROAD
SECOND INDUSTRIAL CITY
RIYADH-11383 K.S.A

CONTRACTOR : ABB Contracting Company
CLIENT : National Gridsa
PROJECT : CONSTRUCTION OF NEW 132/13.8kV SS 8709 IN AL-KHARJ CITY
SUBSTATION : S/S 8709
CONTRACT NO. : 11131113/00
TITLE : Assembly Drawing – +BBP1-1
[132KV BUSBAR PROTECTION MAIN-1 CENTRAL UNIT PANEL]

AS-BUILT BY _____ DATE _____ CONTRACT NO. **11131113/00** JOB ORDER NO. **S-13656**

01	13 49	FACTORY ASBUILT	DRAWN BY RIZ CHECKED BY KVR
00	13 04	FOR APPROVAL	DATE STARTED 24.01.2013 DATE COMPLETED _____
REV. NO.	DATE	DESCRIPTION	OPRG. DEPT. CTPD ENG. DEPT. AUT-PSAC

COVER SHEET

132KV BUSBAR PROT.N.MAIN-1 CU PANEL +BBP1-1
S/S 8709 - 132/13.8KV IN AL-KHARJ CITY
RIYADH SAUDI ARABIA

الشركة الوطنية لنقل الكهرباء



نقل الكهرباء
National Grid sa


INDEX	PLANT NO.	DRAWING NUMBER	SHEET NO.	REV. NO.
-	C421	CD-322990	SHT CONT. 000 001	01

NG/D2-D (2012/01)

DMS


VECTOR

NGD200

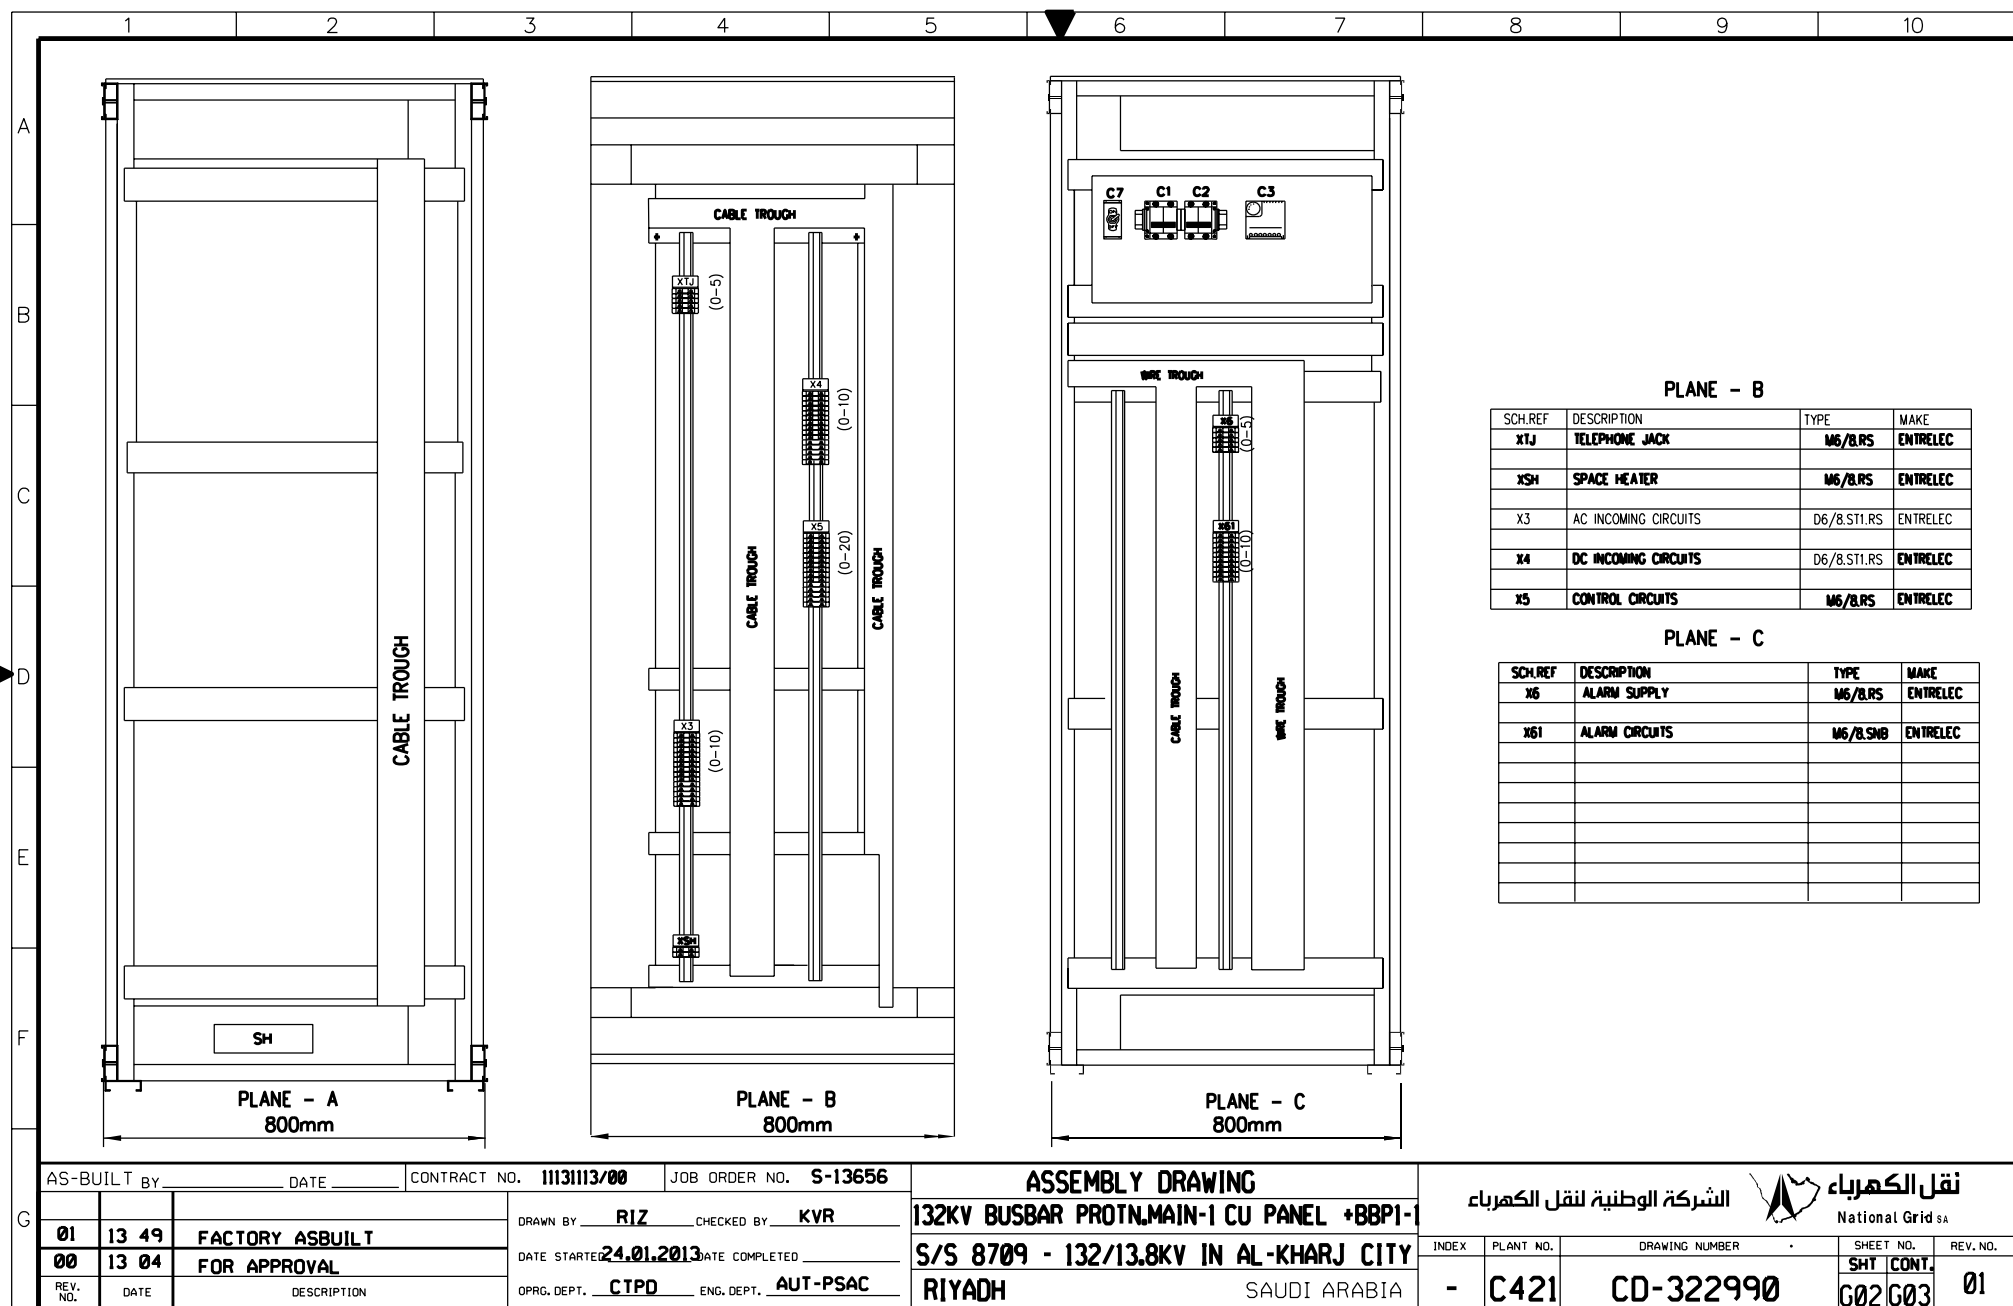


THIS DRAWING AND THE INFORMATION CONTAINED HEREIN ARE THE SOLE PROPERTY OF NATIONAL GRID SA. NO REPRODUCTION IN FULL OR IN PART SHALL BE OBTAINED FROM THIS DOCUMENT WITHOUT THE WRITTEN CONSENT OF ITS OWNER.

BASE PLATE/ FOUNDATION

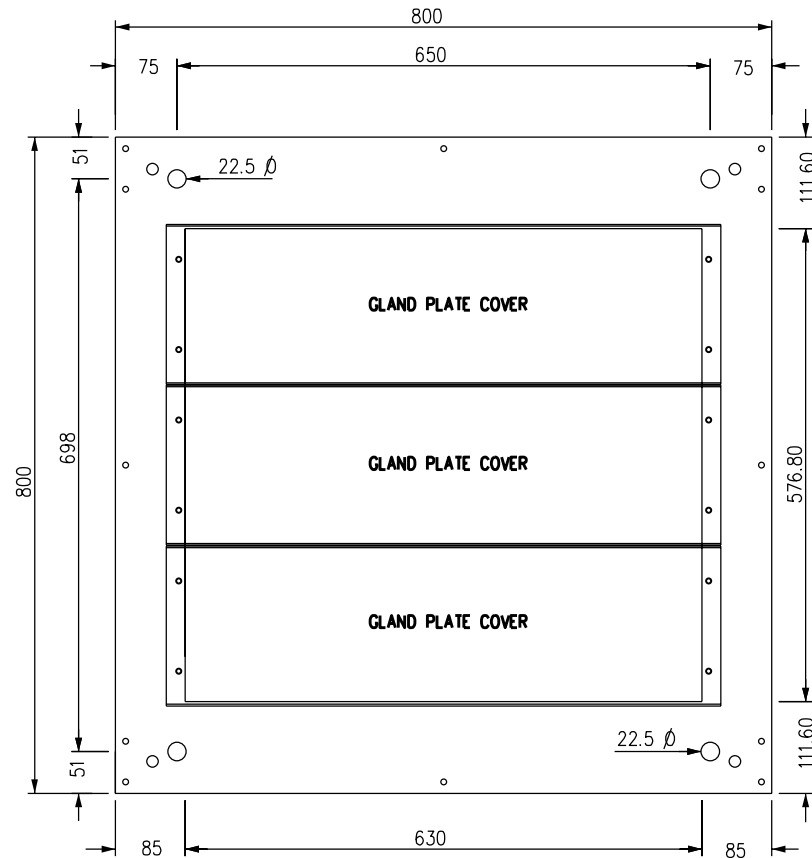

PLAN

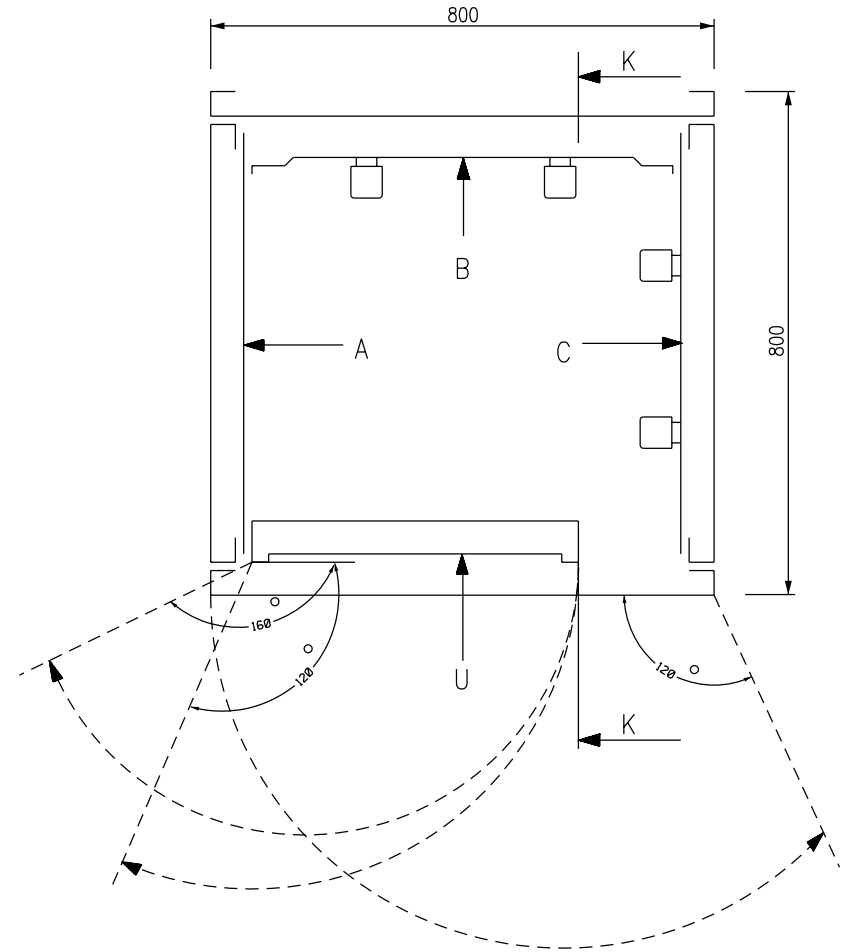

AS-BUILT BY _____ DATE _____ CONTRACT NO. **11131113/00** JOB ORDER NO. **S-13656**

01	13 49	FACTORY ASBUILT	DRAWN BY RIZ CHECKED BY KVR
00	13 04	FOR APPROVAL	DATE STARTED 24.01.2013 DATE COMPLETED _____
REV. NO.	DATE	DESCRIPTION	OPRG. DEPT. CTPD ENG. DEPT. AUT-PSAC

ASSEMBLY DRAWING

132KV BUSBAR PROTN.MAIN-I CU PANEL +BBP1-1
S/S 8709 - 132/13.8KV IN AL-KHARJ CITY
RIYADH SAUDI ARABIA

الشركة الوطنية لنقل الكهرباء



INDEX	PLANT NO.	DRAWING NUMBER	SHEET NO.	REV. NO.
-	C421	CD-322990	SHT CONT. G03 G04	01

NG/D2-D (2012/01)

DMS VECTOR NGD200

THIS DRAWING AND THE INFORMATION CONTAINED HEREIN ARE THE SOLE PROPERTY OF NATIONAL GRID SA. NO REPRODUCTION IN FULL OR IN PART SHALL BE OBTAINED FROM THIS DOCUMENT WITHOUT THE WRITTEN CONSENT OF ITS OWNER.

	1	2	3	4	5	6	7	8	9	10
A										
B										
C										
D										
E										
F										
G										

TOP VIEW FOR EARTHING BAR

U PLANE TOP LABEL

+BBP1-1 132KV BUSBAR PROTECTION MAIN-1 CENTRAL UNIT PANEL

800

28

U PLANE BOTTOM LABEL

ABB AUTOMATION CO. LTD

800

28

MANUFACTURING LABEL

ABB ABB Automation Co.Ltd.

PROJECT : National Grid SA S/S 8709

ORDER REFERENCE : 2875 RF S13656

YEAR OF MANUFACTURE: 2013

PANEL NO. : +BBP1.1

DRAWING NO. : S13656-CD- 322991

MADE IN THE KINGDOM OF SAUDI ARABIA

AS-BUILT BY _____ DATE _____		CONTRACT NO. 11131113/00	JOB ORDER NO. S-13656	ASSEMBLY DRAWING		الشركة الوطنية لنقل الكهرباء		نقل الكهرباء	
01	13 49	FACTORY ASBUILT	DRAWN BY RIZ CHECKED BY KVR	132KV BUSBAR PROTN.MAIN-1 CU PANEL +BBP1-1		National Grid sa			
00	13 04	FOR APPROVAL	DATE STARTED 24.01.2013 DATE COMPLETED	S/S 8709 - 132/13.8KV IN AL-KHARJ CITY					
REV. NO.	DATE	DESCRIPTION	OPRG. DEPT. CTPD ENG. DEPT. AUT-PSAC	RIYADH SAUDI ARABIA		INDEX -	PLANT NO. C421	DRAWING NUMBER CD-322990	SHEET NO. G04 L00



POWER SYSTEMS NETWORK MANAGEMENT
PROTECTION AND SUBSTATION AUTOMATION SYSTEMS
WBS NO: S-13656

ABB AUTOMATION COMPANY LTD
414, AL-KHARJ ROAD
SECOND INDUSTRIAL CITY
RIYADH-11383 K.S.A

CONTRACTOR : ABB Contracting Company
CLIENT : National Gridsa
PROJECT : CONSTRUCTION OF NEW 132/13.8kV SS 8709 IN AL-KHARJ CITY
SUBSTATION : S/S 8709
CONTRACT NO. : 11131113/00
TITLE : LIST OF APPARATUS +BBP1-1
[132KV BUSBAR PROTECTION MAIN-1 CENTRAL UNIT PANEL]

AS-BUILT BY _____ DATE _____ CONTRACT NO. **11131113/00** JOB ORDER NO. **S-13656**

01	13 49	FACTORY ASBUILT	DRAWN BY RIZ CHECKED BY KVR
00	13 04	FOR APPROVAL	DATE STARTED 24.01.2013 DATE COMPLETED _____
REV. NO.	DATE	DESCRIPTION	OPRG. DEPT. CTPD ENG. DEPT. AUT-PSAC

COVER SHEET

132KV BUSBAR PROTN.MAIN-1 CU PANEL +BBP1-1
S/S 8709 - 132/13.8KV IN AL-KHARJ CITY
RIYADH SAUDI ARABIA

الشركة الوطنية لنقل الكهرباء







INDEX	PLANT NO.	DRAWING NUMBER	SHEET NO.	REV. NO.
-	C421	CD-322990	SHT CONT.	01
			L00 L01	

	1	2	3	4	5	6	7	8	9	10
	SR. NO.	LOC. REF	SCH. REF.	D E S C R I P T I O N		SHEET NO.	QTY.	TYPE	MAKE	ORDERING INFORMATION
A				RELAY CUBICLE- ·BBP1-1 FOR 132KV BUSBAR PROTECTION MAIN-1			1	VSH 200	ABB	
				ACCOMODATING THE FOLLOWING						
B	1	U05.5001	87B-50BF-1/CU	CENTRAL UNIT FOR NUMERICAL BUSBAR PROTECTION WITH FOLLOWING		234	1	REB 500	ABB	REB500-CU03-V76-
				HIGH RELIABILITY DUE TO TWO INDEPENDENT MEASUREMENT CRITERIA		298-299				S20-P1-B1-CA3-CB1
C				STABILIZED DIFFERENTIAL CURRENT ALGORITHM						1MRB1500822M6002
				DIRECTIONAL CURRENT COMPARISON ALGORITHM						1MRB150032R0201/B
D				HIGH TROUGH FAULT STABILITY EVEN IN CASE OF CT SATURATION.						
				END FAULT PROTECTION						
E				FULL SOLID STATE BUSBAR REPLICA WITHOUT SWITCHING OF CT CIRCUIT.						
				THEREFORE NO CHECK ZONE REQUIRED						
F				PHASE SEGREGATED MEASUREMENT						
				REDUCE CT PERFORMANCE REQUIREMENTS						
				BUILT IN EVENT RECORDER,BUILT IN EVENT DISTURBANCE RECORDER						
				BUILT IN HUMAN MACHINE INTERFACE,FULLY NUMERICAL SIGNAL PROCESSING						
				BINARY INPUT : 24						
				BINARY OUTPUT : 18						
				FULLY NUMERICAL SIGNAL PROCESSING						
				AUX. VOLTAGE : 48-250V DC						
				RATED FREQUENCY : 60HZ						
	2	U12.101	TS-CU	TEST SWITCH FOR CENTRAL UNIT		232	1	RTXP18	ABB	RK 926 115-AH
	3	U12.107	K01BB	BISTABLE RELAY		232	1	RXMVB 4	ABB	RK 251 401-AP
				AUXILIARY VOLTAGE : 125V DC						
				CONTACT DATA : 1NC-11NO						
				FOR BUS IMAGE ALARM						
	4	U12.119	74DC-1/CU	DUAL TARGET RELAY REVERSE FLAG " BF/BB CENTRAL UNIT DC SUPPLY FAIL"		232	1	RXSF 1	ABB	RK 271 019-AN
				CONTACT DATA : 1NO + 2NC PER COIL						
	5	U16.5001	1PB1	PUSH BUTTON BLACK COLOUR. WITH 2NO CONTACTS		231	1	ML1-100W	ABB	1SFA 616 100 R1006
										1SFA 616 600 R1102
	6	U16.5002	1PB2	PUSH BUTTON BLACK COLOUR. WITH 2NO CONTACTS		231	1	ML1-100W	ABB	1SFA 616 100 R1006
				FOR EXTERNAL RESET						1SFA 616 600 R1102
	7	U16.5003	S01	PUSH BUTTON BLACK COLOUR. WITH 2NO CONTACTS		232	1	ML1-100W	ABB	1SFA 616 100 R1006
				FOR BBP IN SELECTION						1SFA 616 600 R1102
	8	U16.5004	S02	PUSH BUTTON BLACK COLOUR. WITH 2NO CONTACTS		232	1	ML1-100W	ABB	1SFA 616 100 R1006
				FOR BBP OUT SELECTION						1SFA 616 600 R1102

AS-BUILT BY _____ DATE _____		CONTRACT NO. 11131113/00		JOB ORDER NO. S-13656		LIST OF APPARATUS		الشركة الوطنية لنقل الكهرباء		نقل الكهرباء	
01 13 49		FACTORY ASBUILT		DRAWN BY RIZ CHECKED BY KVR		132KV BUSBAR PROTN.MAIN-1 CU PANEL +BBP1-1		National Grid sa			
00 13 04		FOR APPROVAL		DATE STARTED 24.01.2013 DATE COMPLETED _____		S/S 8709 - 132/13.8KV IN AL-KHARJ CITY		INDEX PLANT NO. DRAWING NUMBER		SHT /CONT.	
REV. NO.		DATE		DESCRIPTION		PRG. DEPT. CTPD ENG. DEPT. AUT-PSAC		- C421		CD-322990	
						RIYADH SAUDI ARABIA				01	

	1	2	3	4	5	6	7	8	9	10
	SR. NO.	LOCATION REF.	SCH. REF.	D E S C R I P T I O N		SHT NO.	QTY.	TYPE	MAKE	ORDERING INFORMATION
A	17		X3	SPRING LOADED TERMINAL BLOCKS FOR AC SUPPLY		301	10	D6/8.ST1.RS	ENTRELEC	1SNA 115 831 R0400
			X4	SPRING LOADED TERMINAL BLOCK FOR DC CIRCUIT		301	10	D6/8.ST1.RS	ENTRELEC	1SNA 115 831 R0400
			X5	SPRING LOADED TERMINAL BLOCK FOR CONTROL CIRCUIT		301	20	M6/8.RS	ENTRELEC	1SNA 115 685 R1200
B			X6	SPRING LOADED TERMINAL BLOCK FOR ALARM CIRCUIT		301	5	M6/8.RS	ENTRELEC	1SNA 115 685 R1200
			X61	SRING LOADED TERMINAL BLOCK FOR STN.-COM ALARM PANEL		301	10	M6/8 SNB	ENTRELEC	1SNA 115 688 R2500
			XSH	SPRING LOADED TERMINAL BLOCK FOR SPACE HEATER		301	2	M6/8.RS	ENTRELEC	1SNA 115 688 R2500
C			XTJ	SPRING LOADED TERMINAL BLOCK FOR TELEPHONE JACK		301	5	M6/8.RS	ENTRELEC	1SNA 115 685 R1200
D										
E										
F										

AS-BUILT BY _____ DATE _____		CONTRACT NO. 11131113/00	JOB ORDER NO. S-13656	LIST OF APPARATUS		الشركة الوطنية لنقل الكهرباء		 نقل الكهرباء National Grid sa	
01	13 49	FACTORY ASBUILT		DRAWN BY RIZ	CHECKED BY KVR	132KV BUSBAR PROTN.MAIN-1 CU PANEL +BBP1-1		INDEX	PLANT NO.
00	13 04	FOR APPROVAL		DATE STARTED 24.01.2013	DATE COMPLETED _____	S/S 8709 - 132/13.8KV IN AL-KHARJ CITY		DRAWING NUMBER	SHEET NO.
REV. NO.	DATE	DESCRIPTION		OPRG. DEPT. CTPD	ENG. DEPT. AUT-PSAC	RIYADH SAUDI ARABIA		- C421	CD-322990
								L03	L04
									01

	1	2	3	4	5	6	7	8	9	10																																																																								
A																																																																																		
B																																																																																		
C																																																																																		
D																																																																																		
E																																																																																		
F																																																																																		
G	<table border="1"> <thead> <tr> <th>LABEL REF.</th> <th>LABEL ENGRAVING</th> <th>MATERIALS</th> <th>ENGRAVING</th> <th>LABEL SIZE</th> <th>LETTER SIZE</th> </tr> </thead> <tbody> <tr> <td>U05.5001</td> <td>U05.5001 878+508F-1/CU</td> <td>TRAFOLITE</td> <td>BLACK LETTERS ON WHITE BACKGROUND</td> <td>50X15mm</td> <td>4mm</td> </tr> <tr> <td>U12.101</td> <td>U12.101 1S-CU</td> <td>ALUMINUM PAPER FOIL</td> <td>BLACK LETTERS</td> <td>50X10mm</td> <td>3mm</td> </tr> <tr> <td>U12.107</td> <td>U12.107 R0188</td> <td>ALUMINUM PAPER FOIL</td> <td>BLACK LETTERS</td> <td>50X10mm</td> <td>3mm</td> </tr> <tr> <td>U12.113</td> <td>U12.113 740C-1/CU</td> <td>ALUMINUM PAPER FOIL</td> <td>BLACK LETTERS</td> <td>50X10mm</td> <td>3mm</td> </tr> <tr> <td>U16.5001</td> <td>U16.5001 1PB1</td> <td>TRAFOLITE</td> <td>BLACK LETTERS ON WHITE BACKGROUND</td> <td>50X15mm</td> <td>4mm</td> </tr> <tr> <td>U16.5002</td> <td>U16.5002 1PB2</td> <td>TRAFOLITE</td> <td>BLACK LETTERS ON WHITE BACKGROUND</td> <td>50X15mm</td> <td>4mm</td> </tr> <tr> <td>U16.5003</td> <td>U16.5003 S01</td> <td>TRAFOLITE</td> <td>BLACK LETTERS ON WHITE BACKGROUND</td> <td>50X15mm</td> <td>4mm</td> </tr> <tr> <td>U16.5004</td> <td>U16.5004 S02</td> <td>TRAFOLITE</td> <td>BLACK LETTERS ON WHITE BACKGROUND</td> <td>50X15mm</td> <td>4mm</td> </tr> <tr> <td>U39.5001</td> <td>U39.5001 DC SUPPLY MCB FOR CU</td> <td>TRAFOLITE</td> <td>BLACK LETTERS ON WHITE BACKGROUND</td> <td>50X15mm</td> <td>4mm</td> </tr> <tr> <td>U39.5002</td> <td>U39.5002 COT-127V.C02-220V</td> <td>TRAFOLITE</td> <td>BLACK LETTERS ON WHITE BACKGROUND</td> <td>50X15mm</td> <td>4mm</td> </tr> <tr> <td>U39.5003</td> <td>U39.5003 1J</td> <td>TRAFOLITE</td> <td>BLACK LETTERS ON WHITE BACKGROUND</td> <td>50X15mm</td> <td>4mm</td> </tr> </tbody> </table>										LABEL REF.	LABEL ENGRAVING	MATERIALS	ENGRAVING	LABEL SIZE	LETTER SIZE	U05.5001	U05.5001 878+508F-1/CU	TRAFOLITE	BLACK LETTERS ON WHITE BACKGROUND	50X15mm	4mm	U12.101	U12.101 1S-CU	ALUMINUM PAPER FOIL	BLACK LETTERS	50X10mm	3mm	U12.107	U12.107 R0188	ALUMINUM PAPER FOIL	BLACK LETTERS	50X10mm	3mm	U12.113	U12.113 740C-1/CU	ALUMINUM PAPER FOIL	BLACK LETTERS	50X10mm	3mm	U16.5001	U16.5001 1PB1	TRAFOLITE	BLACK LETTERS ON WHITE BACKGROUND	50X15mm	4mm	U16.5002	U16.5002 1PB2	TRAFOLITE	BLACK LETTERS ON WHITE BACKGROUND	50X15mm	4mm	U16.5003	U16.5003 S01	TRAFOLITE	BLACK LETTERS ON WHITE BACKGROUND	50X15mm	4mm	U16.5004	U16.5004 S02	TRAFOLITE	BLACK LETTERS ON WHITE BACKGROUND	50X15mm	4mm	U39.5001	U39.5001 DC SUPPLY MCB FOR CU	TRAFOLITE	BLACK LETTERS ON WHITE BACKGROUND	50X15mm	4mm	U39.5002	U39.5002 COT-127V.C02-220V	TRAFOLITE	BLACK LETTERS ON WHITE BACKGROUND	50X15mm	4mm	U39.5003	U39.5003 1J	TRAFOLITE	BLACK LETTERS ON WHITE BACKGROUND	50X15mm	4mm
LABEL REF.	LABEL ENGRAVING	MATERIALS	ENGRAVING	LABEL SIZE	LETTER SIZE																																																																													
U05.5001	U05.5001 878+508F-1/CU	TRAFOLITE	BLACK LETTERS ON WHITE BACKGROUND	50X15mm	4mm																																																																													
U12.101	U12.101 1S-CU	ALUMINUM PAPER FOIL	BLACK LETTERS	50X10mm	3mm																																																																													
U12.107	U12.107 R0188	ALUMINUM PAPER FOIL	BLACK LETTERS	50X10mm	3mm																																																																													
U12.113	U12.113 740C-1/CU	ALUMINUM PAPER FOIL	BLACK LETTERS	50X10mm	3mm																																																																													
U16.5001	U16.5001 1PB1	TRAFOLITE	BLACK LETTERS ON WHITE BACKGROUND	50X15mm	4mm																																																																													
U16.5002	U16.5002 1PB2	TRAFOLITE	BLACK LETTERS ON WHITE BACKGROUND	50X15mm	4mm																																																																													
U16.5003	U16.5003 S01	TRAFOLITE	BLACK LETTERS ON WHITE BACKGROUND	50X15mm	4mm																																																																													
U16.5004	U16.5004 S02	TRAFOLITE	BLACK LETTERS ON WHITE BACKGROUND	50X15mm	4mm																																																																													
U39.5001	U39.5001 DC SUPPLY MCB FOR CU	TRAFOLITE	BLACK LETTERS ON WHITE BACKGROUND	50X15mm	4mm																																																																													
U39.5002	U39.5002 COT-127V.C02-220V	TRAFOLITE	BLACK LETTERS ON WHITE BACKGROUND	50X15mm	4mm																																																																													
U39.5003	U39.5003 1J	TRAFOLITE	BLACK LETTERS ON WHITE BACKGROUND	50X15mm	4mm																																																																													
<table border="1"> <tr> <td colspan="2">AS-BUILT BY _____ DATE _____</td> <td>CONTRACT NO. 11131113/00</td> <td>JOB ORDER NO. S-13656</td> <td colspan="2">LIST OF APPARATUS</td> <td colspan="2"> الشركة الوطنية لنقل الكهرباء  نقل الكهرباء National Grid sa </td> </tr> <tr> <td>01</td> <td>13 49</td> <td colspan="2">FACTORY ASBUILT</td> <td colspan="2">132KV BUSBAR PROT.N.MAIN-1 CU PANEL +88PI-1</td> <td>INDEX</td> <td>PLANT NO.</td> </tr> <tr> <td>00</td> <td>13 04</td> <td colspan="2">FOR APPROVAL</td> <td colspan="2">S/S 8709 - 132/13.8KV IN AL-KHARJ CITY</td> <td>DRAWING NUMBER</td> <td>SHEET NO.</td> </tr> <tr> <td>REV. NO.</td> <td>DATE</td> <td>DESCRIPTION</td> <td>OPRG. DEPT. CTPD ENG. DEPT. AUT-PSAC</td> <td colspan="2">RIYADH SAUDI ARABIA</td> <td>-</td> <td>C421</td> </tr> <tr> <td colspan="4"></td> <td colspan="2"></td> <td>CD-322990</td> <td>L04L05</td> </tr> <tr> <td colspan="4"></td> <td colspan="2"></td> <td></td> <td>01</td> </tr> </table>										AS-BUILT BY _____ DATE _____		CONTRACT NO. 11131113/00	JOB ORDER NO. S-13656	LIST OF APPARATUS		الشركة الوطنية لنقل الكهرباء  نقل الكهرباء National Grid sa		01	13 49	FACTORY ASBUILT		132KV BUSBAR PROT.N.MAIN-1 CU PANEL +88PI-1		INDEX	PLANT NO.	00	13 04	FOR APPROVAL		S/S 8709 - 132/13.8KV IN AL-KHARJ CITY		DRAWING NUMBER	SHEET NO.	REV. NO.	DATE	DESCRIPTION	OPRG. DEPT. CTPD ENG. DEPT. AUT-PSAC	RIYADH SAUDI ARABIA		-	C421							CD-322990	L04L05								01																									
AS-BUILT BY _____ DATE _____		CONTRACT NO. 11131113/00	JOB ORDER NO. S-13656	LIST OF APPARATUS		الشركة الوطنية لنقل الكهرباء  نقل الكهرباء National Grid sa																																																																												
01	13 49	FACTORY ASBUILT		132KV BUSBAR PROT.N.MAIN-1 CU PANEL +88PI-1		INDEX	PLANT NO.																																																																											
00	13 04	FOR APPROVAL		S/S 8709 - 132/13.8KV IN AL-KHARJ CITY		DRAWING NUMBER	SHEET NO.																																																																											
REV. NO.	DATE	DESCRIPTION	OPRG. DEPT. CTPD ENG. DEPT. AUT-PSAC	RIYADH SAUDI ARABIA		-	C421																																																																											
						CD-322990	L04L05																																																																											
							01																																																																											

1	2	3	4	5	6	7	8	9	10
A									
B									
C									
D									
E									
F									

LABEL REF.	LABEL ENGRAVING	MATERIALS	ENGRAVING	LABEL SIZE	LETTER SIZE
C1	C1 127V AC SUPPLY MCB	TRAFOLITE	BLACK LETTERS ON WHITE BACKGROUND	50X15mm	4mm
C2	C2 220V AC SUPPLY MCB	TRAFOLITE	BLACK LETTERS ON WHITE BACKGROUND	50X15mm	4mm
C3	C3 THERMOSTAT	TRAFOLITE	BLACK LETTERS ON WHITE BACKGROUND	50X15mm	4mm
C7	C7 ON/OFF SWITCH	TRAFOLITE	BLACK LETTERS ON WHITE BACKGROUND	50X15mm	4mm
DS	DS DOOR SWITCH	TRAFOLITE	BLACK LETTERS ON WHITE BACKGROUND	50X15mm	4mm
IL	IL ILLUMINATION LAMP	TRAFOLITE	BLACK LETTERS ON WHITE BACKGROUND	50X15mm	4mm
SH	SH SPACE HEATER	TRAFOLITE	BLACK LETTERS ON WHITE BACKGROUND	50X15mm	4mm

AS-BUILT BY _____ DATE _____			CONTRACT NO. 11131113/00		JOB ORDER NO. S-13656		LIST OF APPARATUS		نقل الكهرباء الشركة الوطنية لنقل الكهرباء National Grid sa				
01	13 49	FACTORY ASBUILT	DRAWN BY RIZ	CHECKED BY KVR	132KV BUSBAR PROTN.MAIN-1 CU PANEL +BBP1-1 S/S 8709 - 132/13.8KV IN AL-KHARJ CITY RIYADH SAUDI ARABIA				INDEX	PLANT NO.	DRAWING NUMBER	SHEET NO.	REV. NO.
00	13 04	FOR APPROVAL	DATE STARTED 24.01.2013 DATE COMPLETED _____						-	C421	CD-322990	SHT CONT.	01
REV. NO.	DATE	DESCRIPTION	OPRG. DEPT. CTPD ENG. DEPT. AUT-PSAC										



POWER SYSTEMS NETWORK MANAGEMENT
PROTECTION AND SUBSTATION AUTOMATION SYSTEMS
WBS NO: S-13656

ABB AUTOMATION COMPANY LTD.
414, AL-KHARJ ROAD
SECOND INDUSTRIAL CITY
RIYADH-11383 K.S.A

CONTRACTOR : ABB Contracting Company
CLIENT : National GridSA
PROJECT : CONSTRUCTION OF NEW 132/13.8kV SS 8709 IN AL-KHARJ CITY
SUBSTATION : S/S 8709
CONTRACT NO. : 11131113/00
TITLE : SCHEMATICS DRAWINGS - +BBP1-1
[132KV BUSBAR PROTECTION MAIN-1 CENTRAL UNIT PANEL]

AS-BUILT BY _____ DATE _____ CONTRACT NO. **11131113/00** JOB ORDER NO. **S-13656**

01	13 49	FACTORY ASBUILT	DRAWN BY RIZ CHECKED BY KVR
00	13 04	FOR APPROVAL	DATE STARTED 24.01.2013 DATE COMPLETED _____
REV. NO.	DATE	DESCRIPTION	OPRG. DEPT. CTPD ENG. DEPT. AUT-PSAC

COVER SHEET

132KV BUSBAR PROTN.MAIN-1 CU PANEL +BBP1-1
S/S 8709 - 132/13.8KV IN AL-KHARJ CITY
RIYADH SAUDI ARABIA

الشركة الوطنية لنقل الكهرباء



نقل الكهرباء
National Grid SA


INDEX	PLANT NO.	DRAWING NUMBER	SHEET NO.	REV. NO.
-	C421	CD-322991	SHT CONT. 000 001	01

NG/D2-D (2012/01)

DMS

VECTOR

NGD200

	1	2	3	4	5	6	7	8	9	10																																																																																																																																			
A																																																																																																																																													
B																																																																																																																																													
C																																																																																																																																													
D																																																																																																																																													
E																																																																																																																																													
F																																																																																																																																													
G	<table border="1"> <thead> <tr> <th colspan="2">CONTENTS</th> <th>ABB SHT.NO.</th> <th>REV.00</th> <th>REV.01</th> <th>REV.02</th> </tr> </thead> <tbody> <tr><td>COVER SHEET</td><td>000</td><td>X</td><td>X</td><td></td></tr> <tr><td>CONTENTS SHEET</td><td>001</td><td>X</td><td>X</td><td></td></tr> <tr><td>GRAPHICAL SYMBOLS FOR DIAGRAMS</td><td>011</td><td>X</td><td>X</td><td></td></tr> <tr><td>GRAPHICAL SYMBOLS FOR DIAGRAMS</td><td>012</td><td>X</td><td>X</td><td></td></tr> <tr><td>COMMON LEGEND</td><td>013</td><td>X</td><td>X</td><td></td></tr> <tr><td>FERULE AND WIRING DETAILS</td><td>014</td><td>X</td><td>X</td><td></td></tr> <tr><td>DRAWING REFERENCES</td><td>015</td><td>X</td><td>X</td><td></td></tr> <tr><td>DRAWING REFERENCES</td><td>016</td><td>X</td><td>X</td><td></td></tr> <tr><td>AC SUPPLY FOR ILLUMINATION & POWER SOCKET</td><td>211</td><td>X</td><td>X</td><td></td></tr> <tr><td>AC SUPPLY AUXILARY CONTACTS</td><td>212</td><td>X</td><td>X</td><td></td></tr> <tr><td>DC SUPPLY DISTRIBUTION ± R1,</td><td>216</td><td>X</td><td>X</td><td></td></tr> <tr><td>87B+50BF-2/CU PROTECTION RELAY-BINARY INPUTS</td><td>231</td><td>X</td><td>X</td><td></td></tr> <tr><td>BBP IN/OUT SELECTION CIRCUIT</td><td>232</td><td>X</td><td>X</td><td></td></tr> <tr><td>STATION COMMON ALARM CIRCUITS</td><td>233</td><td>X</td><td>X</td><td></td></tr> <tr><td>87B+50BF-2/CU COMMUNICATION TO BAY UNITS</td><td>234</td><td>X</td><td>X</td><td></td></tr> <tr><td>87B+50BF-2/CU INTERNAL DIAGRAM</td><td>298</td><td>X</td><td>X</td><td></td></tr> <tr><td>87B+50BF-2/CU INTERNAL DIAGRAM</td><td>299</td><td>X</td><td>X</td><td></td></tr> <tr><td>TERMINAL BLOCK ALLOCATION</td><td>301</td><td>X</td><td>X</td><td></td></tr> <tr><td></td><td></td><td></td><td></td><td></td></tr> <tr><td></td><td></td><td></td><td></td><td></td></tr> <tr><td></td><td></td><td></td><td></td><td></td></tr> <tr><td></td><td></td><td></td><td></td><td></td></tr> <tr><td></td><td></td><td></td><td></td><td></td></tr> <tr><td></td><td></td><td></td><td></td><td></td></tr> <tr><td></td><td></td><td></td><td></td><td></td></tr> </tbody> </table>										CONTENTS		ABB SHT.NO.	REV.00	REV.01	REV.02	COVER SHEET	000	X	X		CONTENTS SHEET	001	X	X		GRAPHICAL SYMBOLS FOR DIAGRAMS	011	X	X		GRAPHICAL SYMBOLS FOR DIAGRAMS	012	X	X		COMMON LEGEND	013	X	X		FERULE AND WIRING DETAILS	014	X	X		DRAWING REFERENCES	015	X	X		DRAWING REFERENCES	016	X	X		AC SUPPLY FOR ILLUMINATION & POWER SOCKET	211	X	X		AC SUPPLY AUXILARY CONTACTS	212	X	X		DC SUPPLY DISTRIBUTION ± R1,	216	X	X		87B+50BF-2/CU PROTECTION RELAY-BINARY INPUTS	231	X	X		BBP IN/OUT SELECTION CIRCUIT	232	X	X		STATION COMMON ALARM CIRCUITS	233	X	X		87B+50BF-2/CU COMMUNICATION TO BAY UNITS	234	X	X		87B+50BF-2/CU INTERNAL DIAGRAM	298	X	X		87B+50BF-2/CU INTERNAL DIAGRAM	299	X	X		TERMINAL BLOCK ALLOCATION	301	X	X																																				
CONTENTS		ABB SHT.NO.	REV.00	REV.01	REV.02																																																																																																																																								
COVER SHEET	000	X	X																																																																																																																																										
CONTENTS SHEET	001	X	X																																																																																																																																										
GRAPHICAL SYMBOLS FOR DIAGRAMS	011	X	X																																																																																																																																										
GRAPHICAL SYMBOLS FOR DIAGRAMS	012	X	X																																																																																																																																										
COMMON LEGEND	013	X	X																																																																																																																																										
FERULE AND WIRING DETAILS	014	X	X																																																																																																																																										
DRAWING REFERENCES	015	X	X																																																																																																																																										
DRAWING REFERENCES	016	X	X																																																																																																																																										
AC SUPPLY FOR ILLUMINATION & POWER SOCKET	211	X	X																																																																																																																																										
AC SUPPLY AUXILARY CONTACTS	212	X	X																																																																																																																																										
DC SUPPLY DISTRIBUTION ± R1,	216	X	X																																																																																																																																										
87B+50BF-2/CU PROTECTION RELAY-BINARY INPUTS	231	X	X																																																																																																																																										
BBP IN/OUT SELECTION CIRCUIT	232	X	X																																																																																																																																										
STATION COMMON ALARM CIRCUITS	233	X	X																																																																																																																																										
87B+50BF-2/CU COMMUNICATION TO BAY UNITS	234	X	X																																																																																																																																										
87B+50BF-2/CU INTERNAL DIAGRAM	298	X	X																																																																																																																																										
87B+50BF-2/CU INTERNAL DIAGRAM	299	X	X																																																																																																																																										
TERMINAL BLOCK ALLOCATION	301	X	X																																																																																																																																										
AS-BUILT BY _____ DATE _____		CONTRACT NO. 11131113/00		JOB ORDER NO. S-13656		CONTENTS SHEET 132KV BUSBAR PROTN.MAIN-I CU PANEL +BBP1-1 S/S 8709 - 132/13.8KV IN AL-KHARJ CITY RIYADH SAUDI ARABIA		الشركة الوطنية لنقل الكهرباء  نقل الكهرباء National Grid sa		<table border="1"> <thead> <tr> <th>INDEX</th> <th>PLANT NO.</th> <th>DRAWING NUMBER</th> <th>SHEET NO.</th> <th>REV. NO.</th> </tr> </thead> <tbody> <tr> <td>-</td> <td>C421</td> <td>CD-322991</td> <td>001</td> <td>01</td> </tr> </tbody> </table>	INDEX	PLANT NO.	DRAWING NUMBER	SHEET NO.	REV. NO.	-	C421	CD-322991	001	01																																																																																																																									
INDEX	PLANT NO.	DRAWING NUMBER	SHEET NO.	REV. NO.																																																																																																																																									
-	C421	CD-322991	001	01																																																																																																																																									
<table border="1"> <thead> <tr> <th>REV. NO.</th> <th>DATE</th> <th>DESCRIPTION</th> </tr> </thead> <tbody> <tr> <td>01</td> <td>13 49</td> <td>FACTORY ASBUILT</td> </tr> <tr> <td>00</td> <td>13 04</td> <td>FOR APPROVAL</td> </tr> </tbody> </table>	REV. NO.	DATE	DESCRIPTION	01	13 49	FACTORY ASBUILT	00	13 04	FOR APPROVAL	DRAWN BY RIZ CHECKED BY KVR DATE STARTED 24.01.2013 DATE COMPLETED _____ OPRG. DEPT. CTPD ENG. DEPT. AUT-PSAC																																																																																																																																			
REV. NO.	DATE	DESCRIPTION																																																																																																																																											
01	13 49	FACTORY ASBUILT																																																																																																																																											
00	13 04	FOR APPROVAL																																																																																																																																											


1	2	3	4	5	6	7	8	9	10	
A										
B										
C										
D										
E										
F										
G										


SYMBOL	DESCRIPTION	SYMBOL	DESCRIPTION	SYMBOL	DESCRIPTION
	FRAME CONNECTION		MAIN CONTACT OF A CIRCUIT BREAKER PASSING MAKE CONTACT CLOSING MOMENTARILY DURING OPERATION AND RELEASE		RELAY WITH TWO MAKE CONTACTS, ONE OF THEM DELAYED WHEN OPERATING
	EARTH CONNECTION		BREAK CONTACT DELAYED WHEN OPERATING		RELAY WITH TWO ACTUATORS AND A TWO STABLE POSITIONS
	RESISTOR		MAKE CONTACT DELAYED WHEN RELEASING		SIGNALLING LAMP
	VARIABLE RESISTOR		TWO MECHANICAL LINKS CROSSING WITHOUT CONNECTION		MECHANICAL INDICATOR WITH AUTOMATIC RESET
	RESISTOR WITH PRESET ADJUSTMENT		JUNCTION OF MECHANICAL LINKS		MECHANICAL INDICATOR WITH NON-AUTOMATIC RESET
	CAPACITOR		AUTOMATIC RESET		ELECTRICALLY CONTROLLED MECHANICAL INDICATOR WITH AUTOMATIC RESET
	SEMICONDUCTOR DIODE USED AS A CAPACITIVE DEVICE		NON-AUTOMATIC RESET		ELECTRICALLY CONTROLLED MECHANICAL INDICATOR WITH NON-AUTOMATIC RESET
	OPEN CONTACT, MAKE CONTACT		SWITCHING DEVICE WITH MANUAL OPERATION AND WITH AUTOMATIC RESET		RELAY WITH MAKE CONTACT
	CLOSED CONTACT, BREAK CONTACT		SWITCHING DEVICE WITH MANUAL OPERATION AND WITH NON-AUTOMATIC RESET		RELAY WITH CHANGE-OVER CONTACT
	CHANGE-OVER CONTACT, BREAK BEFORE MAKE		CHANGE-OVER SWITCHING DEVICE WITH MANUAL CONTROL		RELAY WITH MAKE CONTACT, DELAYED WHEN OPERATING
	MAKE CONTACT WHICH IS EARLY WHEN OPERATING AND LATE WHEN RELEASING		RELAY WITH MAKE CONTACT, DELAYED WHEN RELEASING		RELAY WITH MAKE CONTACT, DELAYED WHEN OPERATING AND RELEASING
	BREAK CONTACT WHICH IS LATE WHEN OPERATING AND EARLY WHEN RELEASING				
	SWITCHING DEVICE WITH MANUAL CONTROL				
	MAKE CONTACT DELAYED WHEN OPERATING				
	BREAK CONTACT DELAYED WHEN RELEASING				
	MAKE CONTACT DELAYED WHEN OPERATING AND RELEASING				
	MAIN CONTACT OF A SWITCH DISCONNECTOR				
	MAIN CONTACT OF A DISCONNECTOR				

AS-BUILT BY _____ DATE _____		CONTRACT NO. 11131113/00		JOB ORDER NO. S-13656		GRAPHICAL SYMBOLS FOR DIAGRAMS		الشركة الوطنية لنقل الكهرباء	
DRAWN BY RIZ		CHECKED BY KVR		132KV BUSBAR PROTN.MAIN-1 CU PANEL +BBPI-1		National Grid sa			
DATE STARTED 24.01.2013		DATE COMPLETED _____		S/S 8709 - 132/13.8KV IN AL-KHARJ CITY		INDEX		PLANT NO.	
OPRG. DEPT. CTPD		ENG. DEPT. AUT-PSAC		RIYADH SAUDI ARABIA		- C421		CD-322991	
REV. NO.		DATE		DESCRIPTION		SHEET NO.		REV. NO.	
01		13 49		FACTORY ASBUILT		011		012	
00		13 04		FOR APPROVAL		01		01	


	1	2	3	4	5	6	7	8	9	10																																																																																																						
A																																																																																																																
B																																																																																																																
C																																																																																																																
D																																																																																																																
E																																																																																																																
F																																																																																																																
<table><tr><th>SYMBOL</th><th>DESCRIPTION</th><th>SYMBOL</th><th>DESCRIPTION</th><th>SYMBOL</th><th>DESCRIPTION</th></tr><tr><td></td><td>FUSE / LINK</td><td></td><td>WATTMETER</td><td></td><td>ELEMENT WITH NEGATED INHIBITING INPUT</td></tr><tr><td></td><td>FUSE WITH THE SUPPLY SIDE INDICATED</td><td></td><td>VARMETER</td><td></td><td>ELEMENT WITH INPUT WHICH DOES NOT CARRY ANY LOGIC INFORMATION</td></tr><tr><td></td><td>SINGLE-PHASE TRANSFORMER WITH TWO SEPARATE WINDINGS (TWO ALTERNATIVE FORMS)</td><td></td><td>POWER FACTOR METER</td><td></td><td>ELEMENT WITH POSTPONED OUTPUT</td></tr><tr><td></td><td>SINGLE-PHASE TRANSFORMER WITH TWO SEPARATE WINDINGS (TWO ALTERNATIVE FORMS)</td><td></td><td>POSITION INDICATOR</td><td></td><td>AND-ELEMENT WITH TWO INPUTS</td></tr><tr><td></td><td>SINGLE-PHASE TRANSFORMER WITH FERRO MAGNETIC CORE</td><td></td><td>SYNCHROSCOPE</td><td></td><td>OR-ELEMENT WITH TWO INPUTS</td></tr><tr><td></td><td>SINGLE-PHASE VOLTAGE TRANSFORMER (MULTI-LINE AND SINGLE-LINE REPRESENTATION)</td><td></td><td>RECORDING VOLTMETER</td><td></td><td>LOGIC THRESHOLD ELEMENT WITH FOUR INPUTS AND THRESHOLD VALUE 2</td></tr><tr><td></td><td>SINGLE-PHASE VOLTAGE TRANSFORMER WITH TWO SECONDARY WINDINGS (MULTI-LINE AND SINGLE-LINE REPRESENTATION)</td><td></td><td>RECORDING WATTMETER</td><td></td><td>ELEMENT WITH THREE INPUTS FOR "2 AND ONLY 2"</td></tr><tr><td></td><td>CURRENT TRANSFORMER (MULTI-LINE AND SINGLE-LINE REPRESENTATION)</td><td></td><td>HOUR METER</td><td></td><td>EXCLUSIVE OR-ELEMENT WITH THREE INPUTS</td></tr><tr><td></td><td>CURRENT TRANSFORMER WITH TWO CORES (MULTI-LINE AND SINGLE-LINE REPRESENTATION)</td><td></td><td>WATT-HOUR METER</td><td></td><td>LOGIC IDENTITY ELEMENT WITH THREE INPUTS</td></tr><tr><td></td><td>CURRENT TRANSFORMER WITH TWO SECONDARY WINDINGS ON ONE CORE (MULTI-LINE AND SINGLE-LINE REPRESENTATION)</td><td></td><td>WATT-HOUR METER FOR ENERGY FROM A BUSBAR SYSTEM</td><td></td><td>MAJORITY ELEMENT WITH THREE INPUTS</td></tr><tr><td></td><td>FILTER</td><td></td><td>ELEMENT WITH STATIC INPUT</td><td></td><td>NEGATOR</td></tr><tr><td></td><td>HIGH-PASS FILTER</td><td></td><td>ELEMENT WITH STATIC NEGATED INPUT</td><td></td><td>NAND ELEMENT WITH TWO INPUTS</td></tr><tr><td></td><td>BAND-PASS FILTER</td><td></td><td>ELEMENT WITH STATIC NEGATED OUTPUT</td><td></td><td>NOR ELEMENT WITH TWO INPUTS</td></tr><tr><td></td><td>VOLTMETER</td><td></td><td>ELEMENT WITH DYNAMIC INPUT</td><td></td><td>BISTABLE ELEMENT</td></tr><tr><td></td><td>AMMETER</td><td></td><td>ELEMENT WITH DYNAMIC NEGATED INPUT</td><td></td><td></td></tr><tr><td></td><td></td><td></td><td>ELEMENT WITH INHIBITING INPUT</td><td></td><td></td></tr></table>											SYMBOL	DESCRIPTION	SYMBOL	DESCRIPTION	SYMBOL	DESCRIPTION		FUSE / LINK		WATTMETER		ELEMENT WITH NEGATED INHIBITING INPUT		FUSE WITH THE SUPPLY SIDE INDICATED		VARMETER		ELEMENT WITH INPUT WHICH DOES NOT CARRY ANY LOGIC INFORMATION		SINGLE-PHASE TRANSFORMER WITH TWO SEPARATE WINDINGS (TWO ALTERNATIVE FORMS)		POWER FACTOR METER		ELEMENT WITH POSTPONED OUTPUT		SINGLE-PHASE TRANSFORMER WITH TWO SEPARATE WINDINGS (TWO ALTERNATIVE FORMS)		POSITION INDICATOR		AND-ELEMENT WITH TWO INPUTS		SINGLE-PHASE TRANSFORMER WITH FERRO MAGNETIC CORE		SYNCHROSCOPE		OR-ELEMENT WITH TWO INPUTS		SINGLE-PHASE VOLTAGE TRANSFORMER (MULTI-LINE AND SINGLE-LINE REPRESENTATION)		RECORDING VOLTMETER		LOGIC THRESHOLD ELEMENT WITH FOUR INPUTS AND THRESHOLD VALUE 2		SINGLE-PHASE VOLTAGE TRANSFORMER WITH TWO SECONDARY WINDINGS (MULTI-LINE AND SINGLE-LINE REPRESENTATION)		RECORDING WATTMETER		ELEMENT WITH THREE INPUTS FOR "2 AND ONLY 2"		CURRENT TRANSFORMER (MULTI-LINE AND SINGLE-LINE REPRESENTATION)		HOUR METER		EXCLUSIVE OR-ELEMENT WITH THREE INPUTS		CURRENT TRANSFORMER WITH TWO CORES (MULTI-LINE AND SINGLE-LINE REPRESENTATION)		WATT-HOUR METER		LOGIC IDENTITY ELEMENT WITH THREE INPUTS		CURRENT TRANSFORMER WITH TWO SECONDARY WINDINGS ON ONE CORE (MULTI-LINE AND SINGLE-LINE REPRESENTATION)		WATT-HOUR METER FOR ENERGY FROM A BUSBAR SYSTEM		MAJORITY ELEMENT WITH THREE INPUTS		FILTER		ELEMENT WITH STATIC INPUT		NEGATOR		HIGH-PASS FILTER		ELEMENT WITH STATIC NEGATED INPUT		NAND ELEMENT WITH TWO INPUTS		BAND-PASS FILTER		ELEMENT WITH STATIC NEGATED OUTPUT		NOR ELEMENT WITH TWO INPUTS		VOLTMETER		ELEMENT WITH DYNAMIC INPUT		BISTABLE ELEMENT		AMMETER		ELEMENT WITH DYNAMIC NEGATED INPUT						ELEMENT WITH INHIBITING INPUT		
SYMBOL	DESCRIPTION	SYMBOL	DESCRIPTION	SYMBOL	DESCRIPTION																																																																																																											
	FUSE / LINK		WATTMETER		ELEMENT WITH NEGATED INHIBITING INPUT																																																																																																											
	FUSE WITH THE SUPPLY SIDE INDICATED		VARMETER		ELEMENT WITH INPUT WHICH DOES NOT CARRY ANY LOGIC INFORMATION																																																																																																											
	SINGLE-PHASE TRANSFORMER WITH TWO SEPARATE WINDINGS (TWO ALTERNATIVE FORMS)		POWER FACTOR METER		ELEMENT WITH POSTPONED OUTPUT																																																																																																											
	SINGLE-PHASE TRANSFORMER WITH TWO SEPARATE WINDINGS (TWO ALTERNATIVE FORMS)		POSITION INDICATOR		AND-ELEMENT WITH TWO INPUTS																																																																																																											
	SINGLE-PHASE TRANSFORMER WITH FERRO MAGNETIC CORE		SYNCHROSCOPE		OR-ELEMENT WITH TWO INPUTS																																																																																																											
	SINGLE-PHASE VOLTAGE TRANSFORMER (MULTI-LINE AND SINGLE-LINE REPRESENTATION)		RECORDING VOLTMETER		LOGIC THRESHOLD ELEMENT WITH FOUR INPUTS AND THRESHOLD VALUE 2																																																																																																											
	SINGLE-PHASE VOLTAGE TRANSFORMER WITH TWO SECONDARY WINDINGS (MULTI-LINE AND SINGLE-LINE REPRESENTATION)		RECORDING WATTMETER		ELEMENT WITH THREE INPUTS FOR "2 AND ONLY 2"																																																																																																											
	CURRENT TRANSFORMER (MULTI-LINE AND SINGLE-LINE REPRESENTATION)		HOUR METER		EXCLUSIVE OR-ELEMENT WITH THREE INPUTS																																																																																																											
	CURRENT TRANSFORMER WITH TWO CORES (MULTI-LINE AND SINGLE-LINE REPRESENTATION)		WATT-HOUR METER		LOGIC IDENTITY ELEMENT WITH THREE INPUTS																																																																																																											
	CURRENT TRANSFORMER WITH TWO SECONDARY WINDINGS ON ONE CORE (MULTI-LINE AND SINGLE-LINE REPRESENTATION)		WATT-HOUR METER FOR ENERGY FROM A BUSBAR SYSTEM		MAJORITY ELEMENT WITH THREE INPUTS																																																																																																											
	FILTER		ELEMENT WITH STATIC INPUT		NEGATOR																																																																																																											
	HIGH-PASS FILTER		ELEMENT WITH STATIC NEGATED INPUT		NAND ELEMENT WITH TWO INPUTS																																																																																																											
	BAND-PASS FILTER		ELEMENT WITH STATIC NEGATED OUTPUT		NOR ELEMENT WITH TWO INPUTS																																																																																																											
	VOLTMETER		ELEMENT WITH DYNAMIC INPUT		BISTABLE ELEMENT																																																																																																											
	AMMETER		ELEMENT WITH DYNAMIC NEGATED INPUT																																																																																																													
			ELEMENT WITH INHIBITING INPUT																																																																																																													
G	<table><tr><td colspan="3">AS-BUILT BY _____ DATE _____</td><td colspan="2">CONTRACT NO. 11131113/00</td><td colspan="2">JOB ORDER NO. S-13656</td><td colspan="3">GRAPHICAL SYMBOLS FOR DIAGRAMS</td></tr><tr><td>01</td><td>13 49</td><td>FACTORY ASBUILT</td><td colspan="2">DRAWN BY RIZ CHECKED BY KVR</td><td colspan="5">132KV BUSBAR PROTN.MAIN-I CU PANEL +BBP1-I</td></tr><tr><td>00</td><td>13 04</td><td>FOR APPROVAL</td><td colspan="2">DATE STARTED 24.01.2013 DATE COMPLETED _____</td><td colspan="5">S/S 8709 - 132/13.8KV IN AL-KHARJ CITY</td></tr><tr><td>REV. NO.</td><td>DATE</td><td>DESCRIPTION</td><td colspan="2">OPRG. DEPT. CTPD ENG. DEPT. AUT-PSAC</td><td colspan="5">RIYADH SAUDI ARABIA</td></tr></table> <div><div>الشركة الوطنية لنقل الكهرباء</div><div></div><div>National Grid sa</div></div> <table><tr><td>INDEX</td><td>PLANT NO.</td><td>DRAWING NUMBER</td><td>SHEET NO.</td><td>REV. NO.</td></tr><tr><td>-</td><td>C421</td><td>CD-322991</td><td>012 013</td><td>01</td></tr></table>										AS-BUILT BY _____ DATE _____			CONTRACT NO. 11131113/00		JOB ORDER NO. S-13656		GRAPHICAL SYMBOLS FOR DIAGRAMS			01	13 49	FACTORY ASBUILT	DRAWN BY RIZ CHECKED BY KVR		132KV BUSBAR PROTN.MAIN-I CU PANEL +BBP1-I					00	13 04	FOR APPROVAL	DATE STARTED 24.01.2013 DATE COMPLETED _____		S/S 8709 - 132/13.8KV IN AL-KHARJ CITY					REV. NO.	DATE	DESCRIPTION	OPRG. DEPT. CTPD ENG. DEPT. AUT-PSAC		RIYADH SAUDI ARABIA					INDEX	PLANT NO.	DRAWING NUMBER	SHEET NO.	REV. NO.	-	C421	CD-322991	012 013	01																																																				
AS-BUILT BY _____ DATE _____			CONTRACT NO. 11131113/00		JOB ORDER NO. S-13656		GRAPHICAL SYMBOLS FOR DIAGRAMS																																																																																																									
01	13 49	FACTORY ASBUILT	DRAWN BY RIZ CHECKED BY KVR		132KV BUSBAR PROTN.MAIN-I CU PANEL +BBP1-I																																																																																																											
00	13 04	FOR APPROVAL	DATE STARTED 24.01.2013 DATE COMPLETED _____		S/S 8709 - 132/13.8KV IN AL-KHARJ CITY																																																																																																											
REV. NO.	DATE	DESCRIPTION	OPRG. DEPT. CTPD ENG. DEPT. AUT-PSAC		RIYADH SAUDI ARABIA																																																																																																											
INDEX	PLANT NO.	DRAWING NUMBER	SHEET NO.	REV. NO.																																																																																																												
-	C421	CD-322991	012 013	01																																																																																																												


THIS DRAWING AND THE INFORMATION CONTAINED HEREIN ARE THE SOLE PROPERTY OF NATIONAL GRID SA. NO REPRODUCTION IN FULL OR IN PART SHALL BE OBTAINED FROM THIS DOCUMENT WITHOUT THE WRITTEN CONSENT OF ITS OWNER.

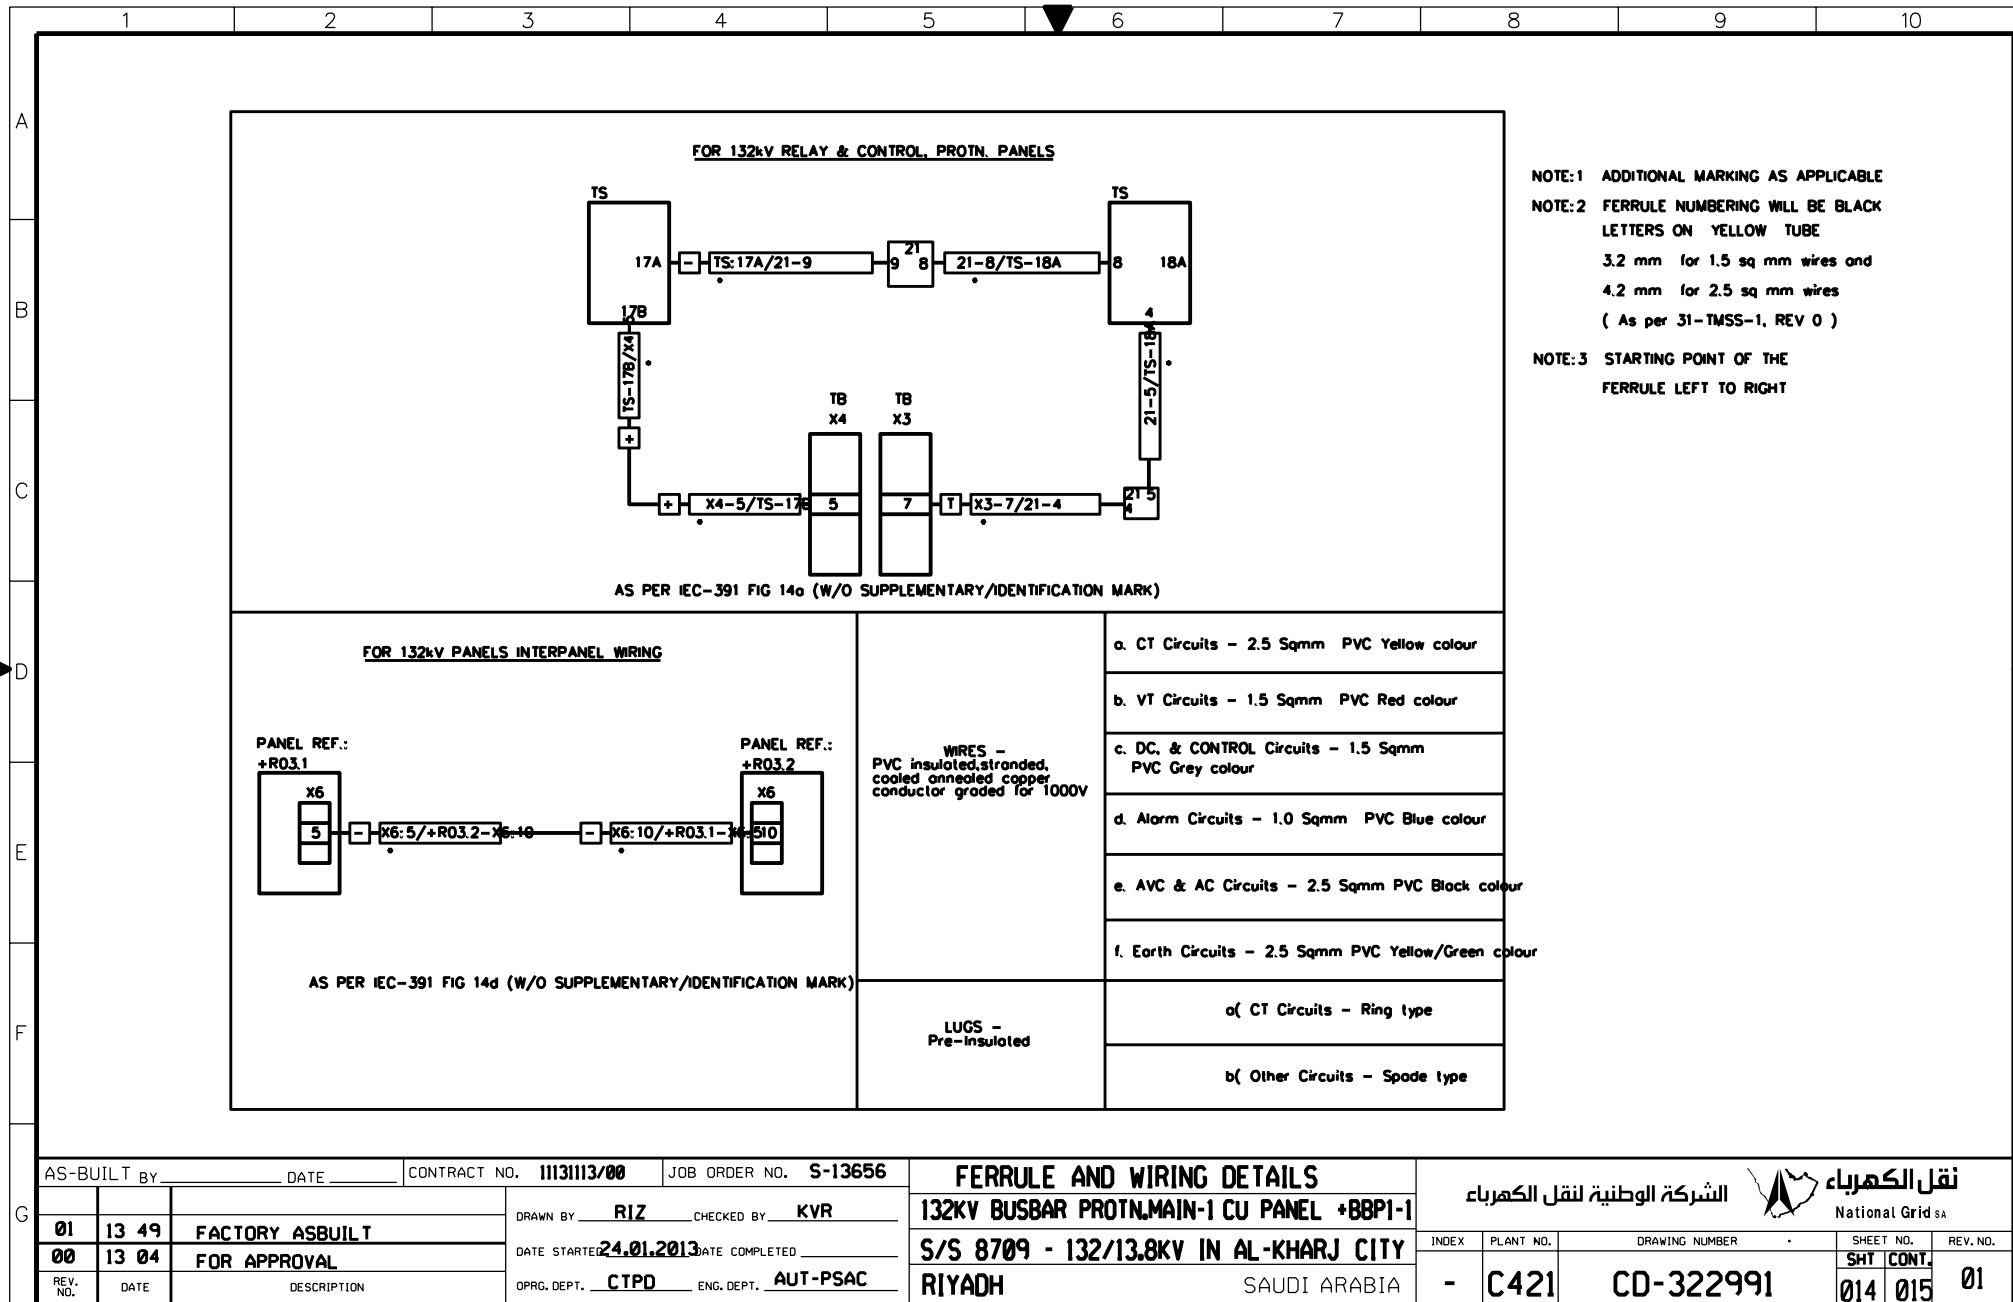



MANUFACTURER	SCHEMATICS DWG.NO	PANEL DESCRIPTION	PANEL REFERENCE
<div> PROTECTION & SUBSTATION AUTOMATION</div>		SS 8709 13.8KV RELAY PANELS	
	CD-322952	13.8KV Copocitor Bank-1 Protection Panel	+CBP-1
	CD-322954	13.8KV Copocitor Bank-2 Protection Panel	+CBP-2
	CD-322956	13.8KV Copocitor Bank-2 Protection Panel	+CBP-3
	CD-322958	13.8 KV ACCS PANEL	+ACCS
	CD-322962	13.8KV ACSE PANEL	+ACSE
	CD-322968	13.8KV Under Voltage Load Shedding Panel	+UVLS
	CD-322964	13.8KV Under Frequency Load Shedding Panel-1	+UFLS01
	CD-322966	13.8KV Under Frequency Load Shedding Panel-2	+UFLS02

AS-BUILT BY _____ DATE _____			CONTRACT NO. 11131113/00		JOB ORDER NO. S-13656		DRAWING REFERENCES		الشركة الوطنية لنقل الكهرباء National Grid sa									
01 13 49 FACTORY ASBUILT			DRAWN BY RIZ		CHECKED BY KVR		132KV BUSBAR PROTN.MAIN-1 CU PANEL +8BP1-1		INDEX		PLANT NO.		DRAWING NUMBER		SHEET NO.		REV. NO.	
00 13 04 FOR APPROVAL			DATE STARTED 24.01.2013		DATE COMPLETED		S/S 8709 - 132/13.8KV IN AL-KHARJ CITY		-		C421		CD-322991		016 211		01	
REV. NO. DATE DESCRIPTION			OPRG. DEPT. CTPD		ENG. DEPT. AUT-PSAC		RIYADH SAUDI ARABIA											

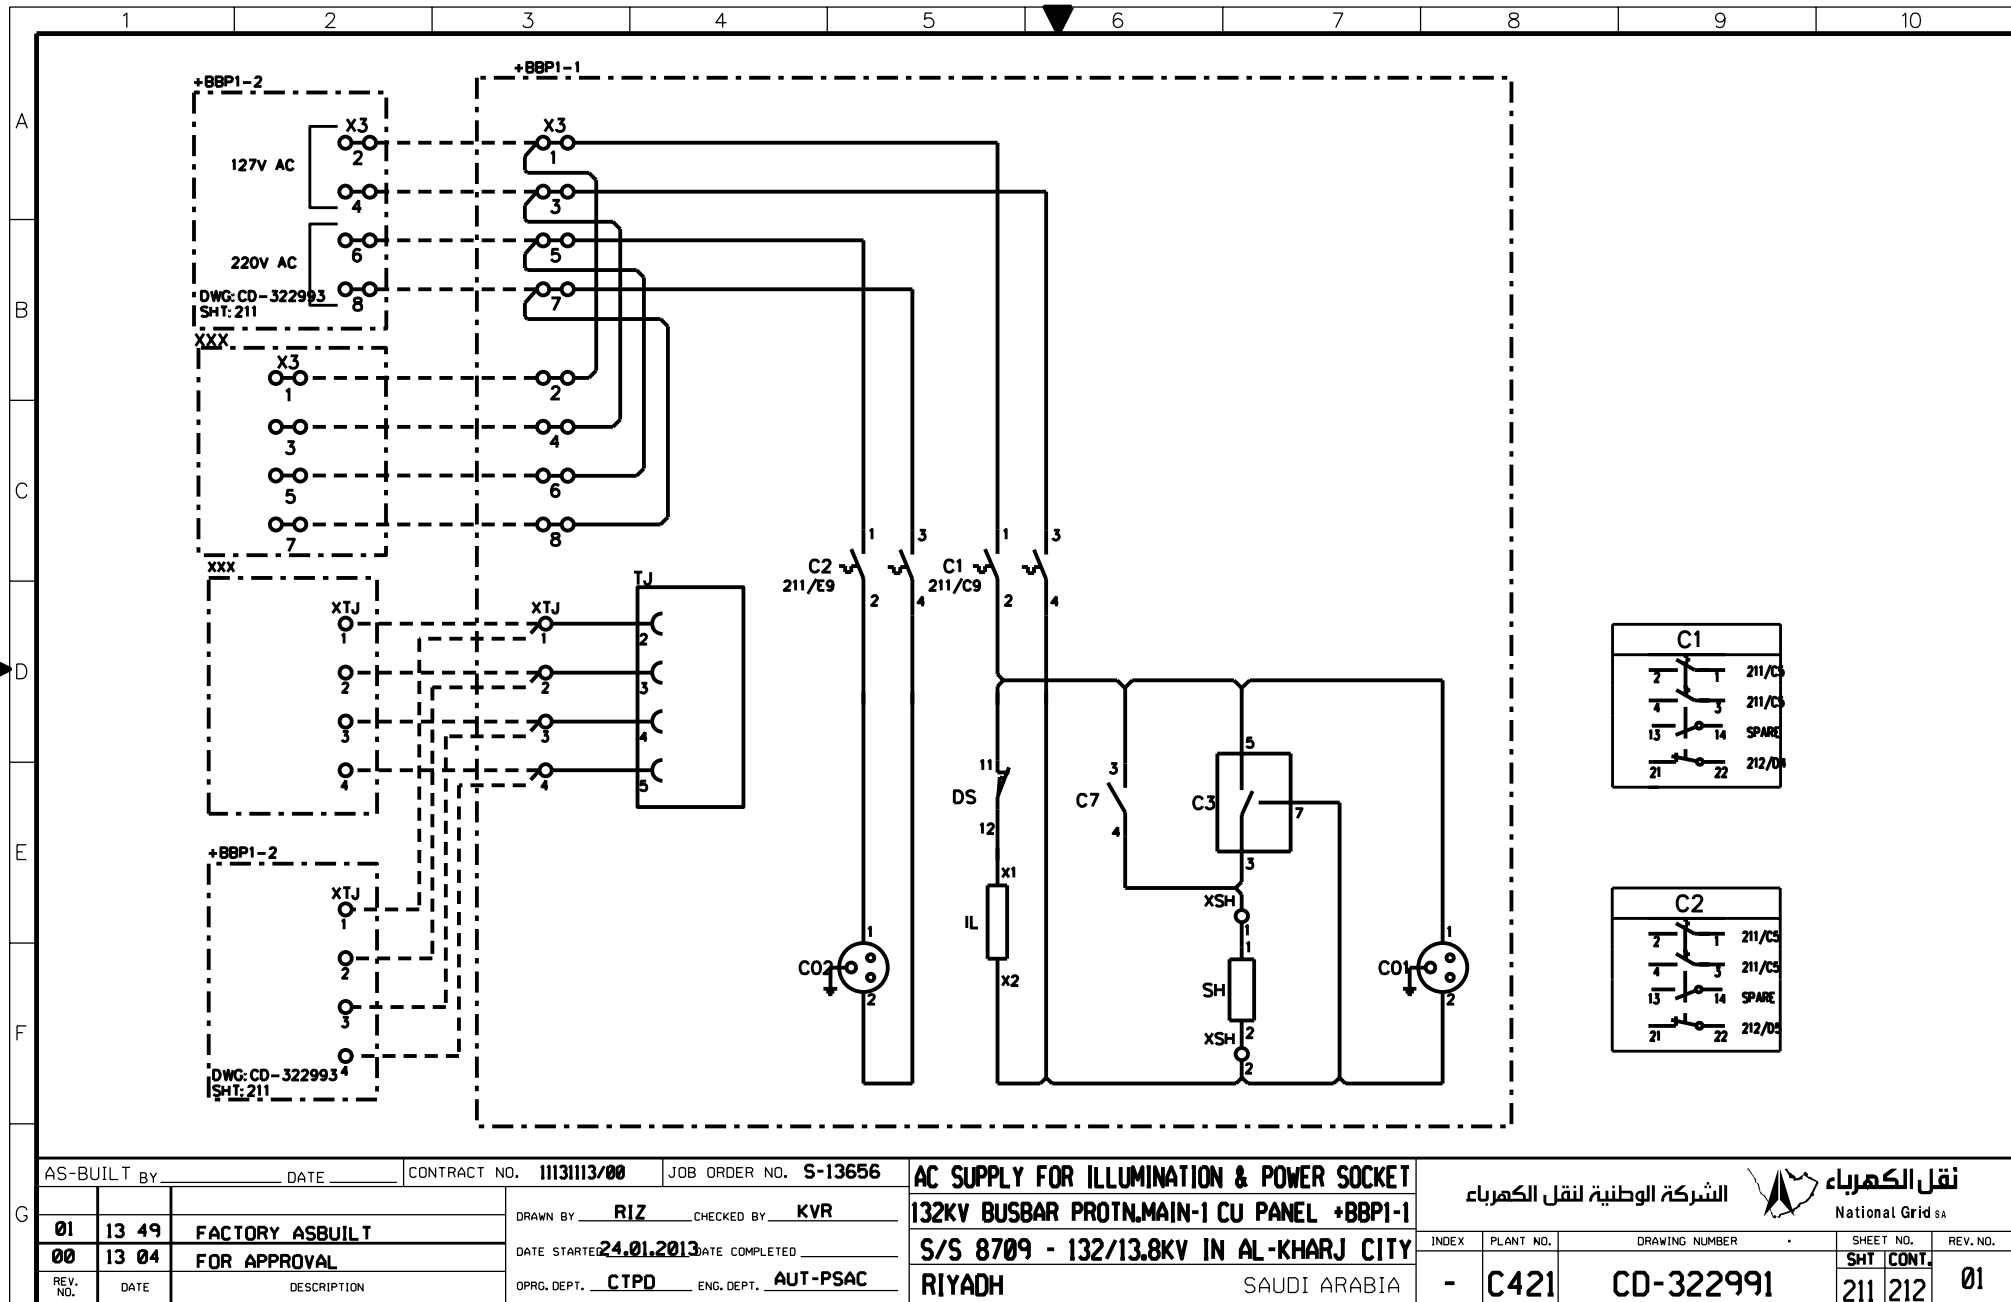

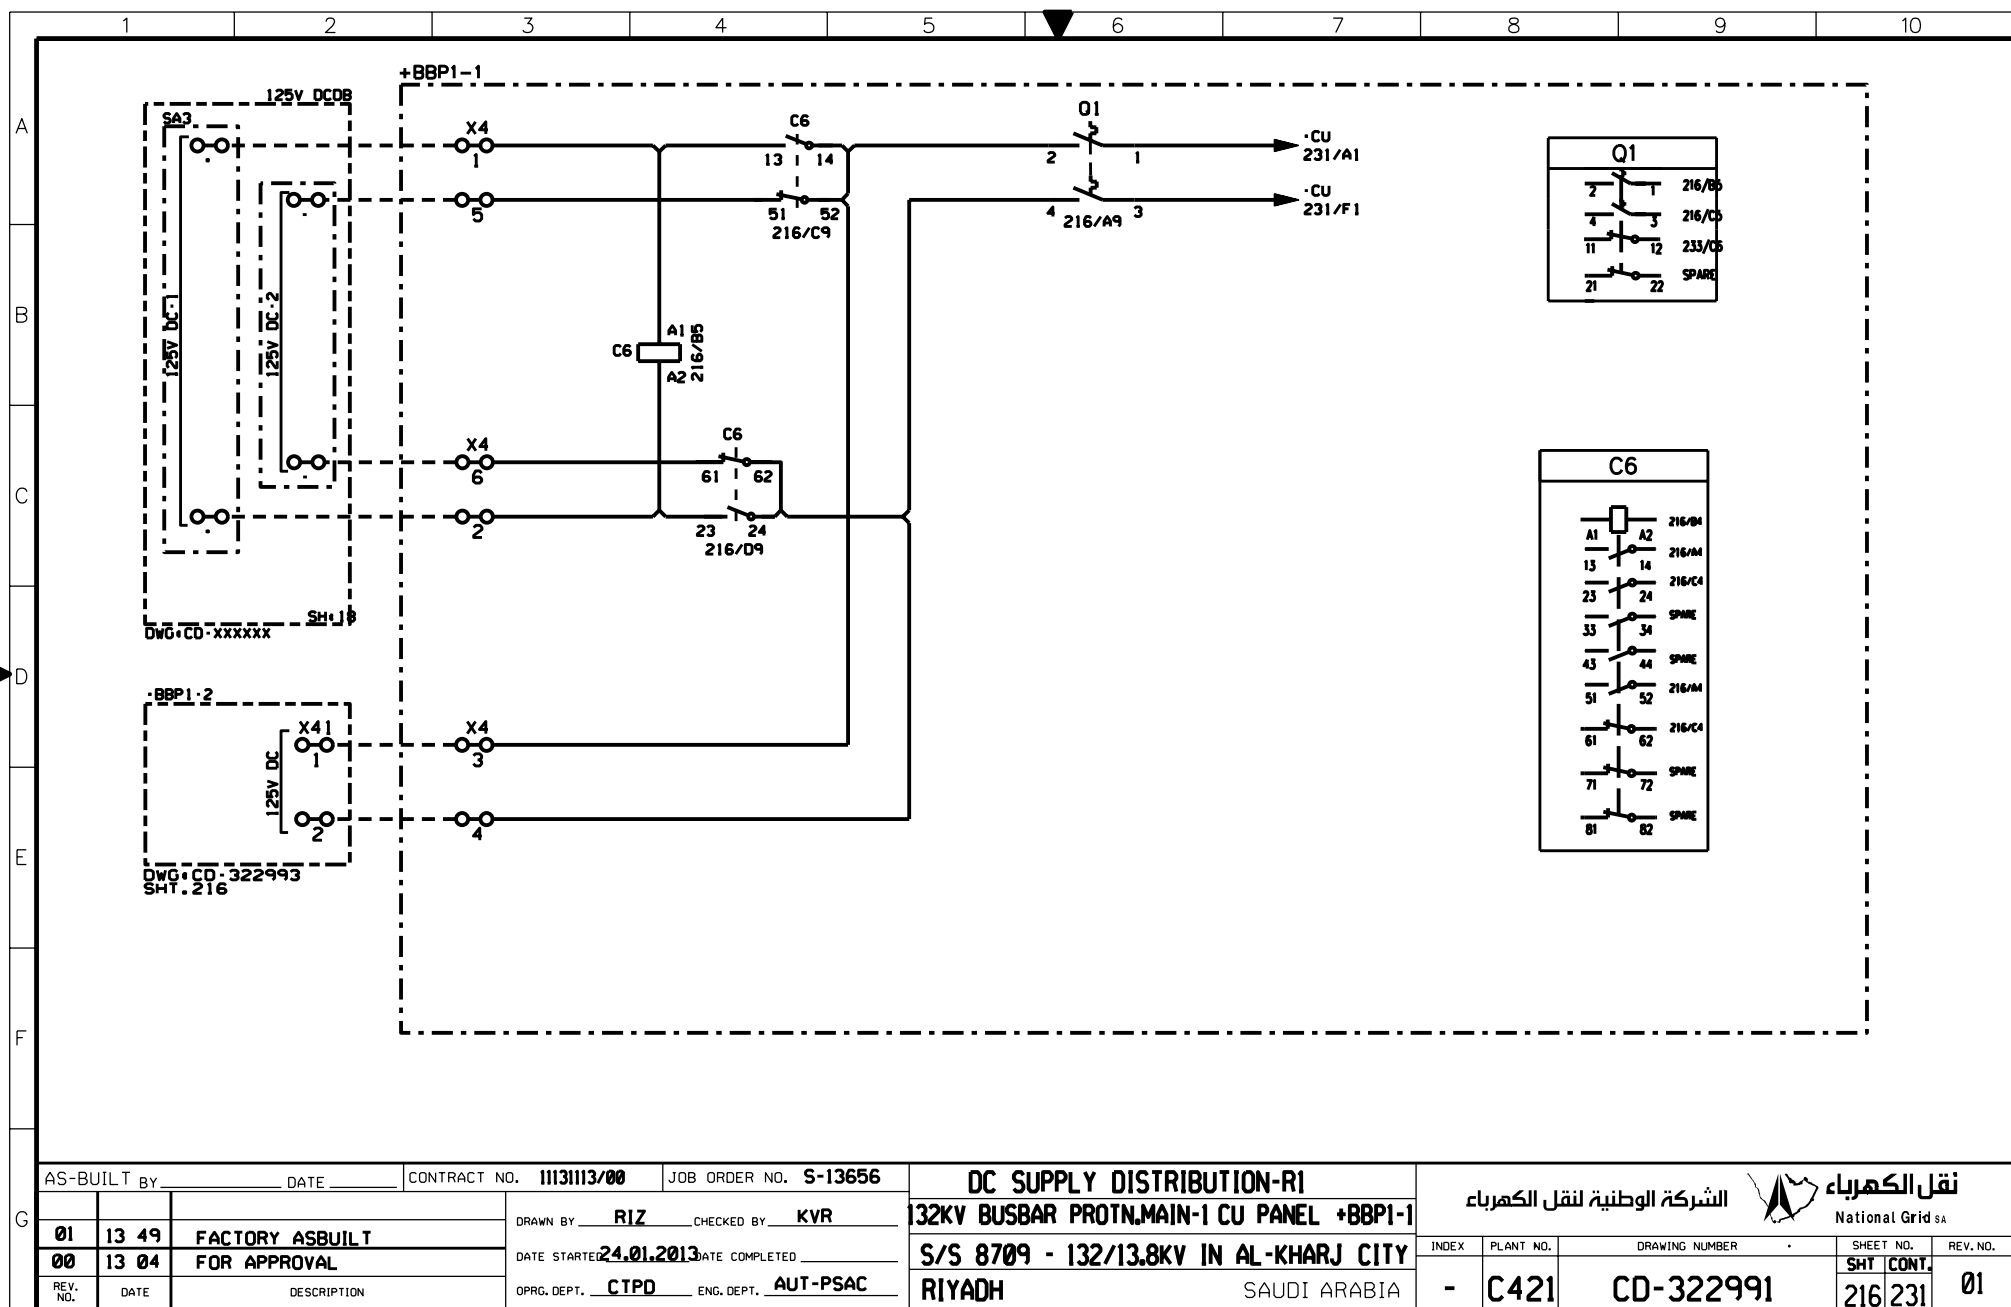

THIS DRAWING AND THE INFORMATION CONTAINED HEREIN ARE THE SOLE PROPERTY OF NGD200. NO REPRODUCTION IN FULL OR IN PART SHALL BE OBTAINED FROM THIS DOCUMENT WITHOUT THE WRITTEN CONSENT OF ITS OWNER.

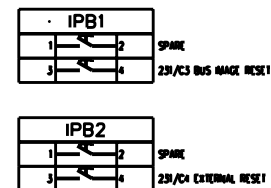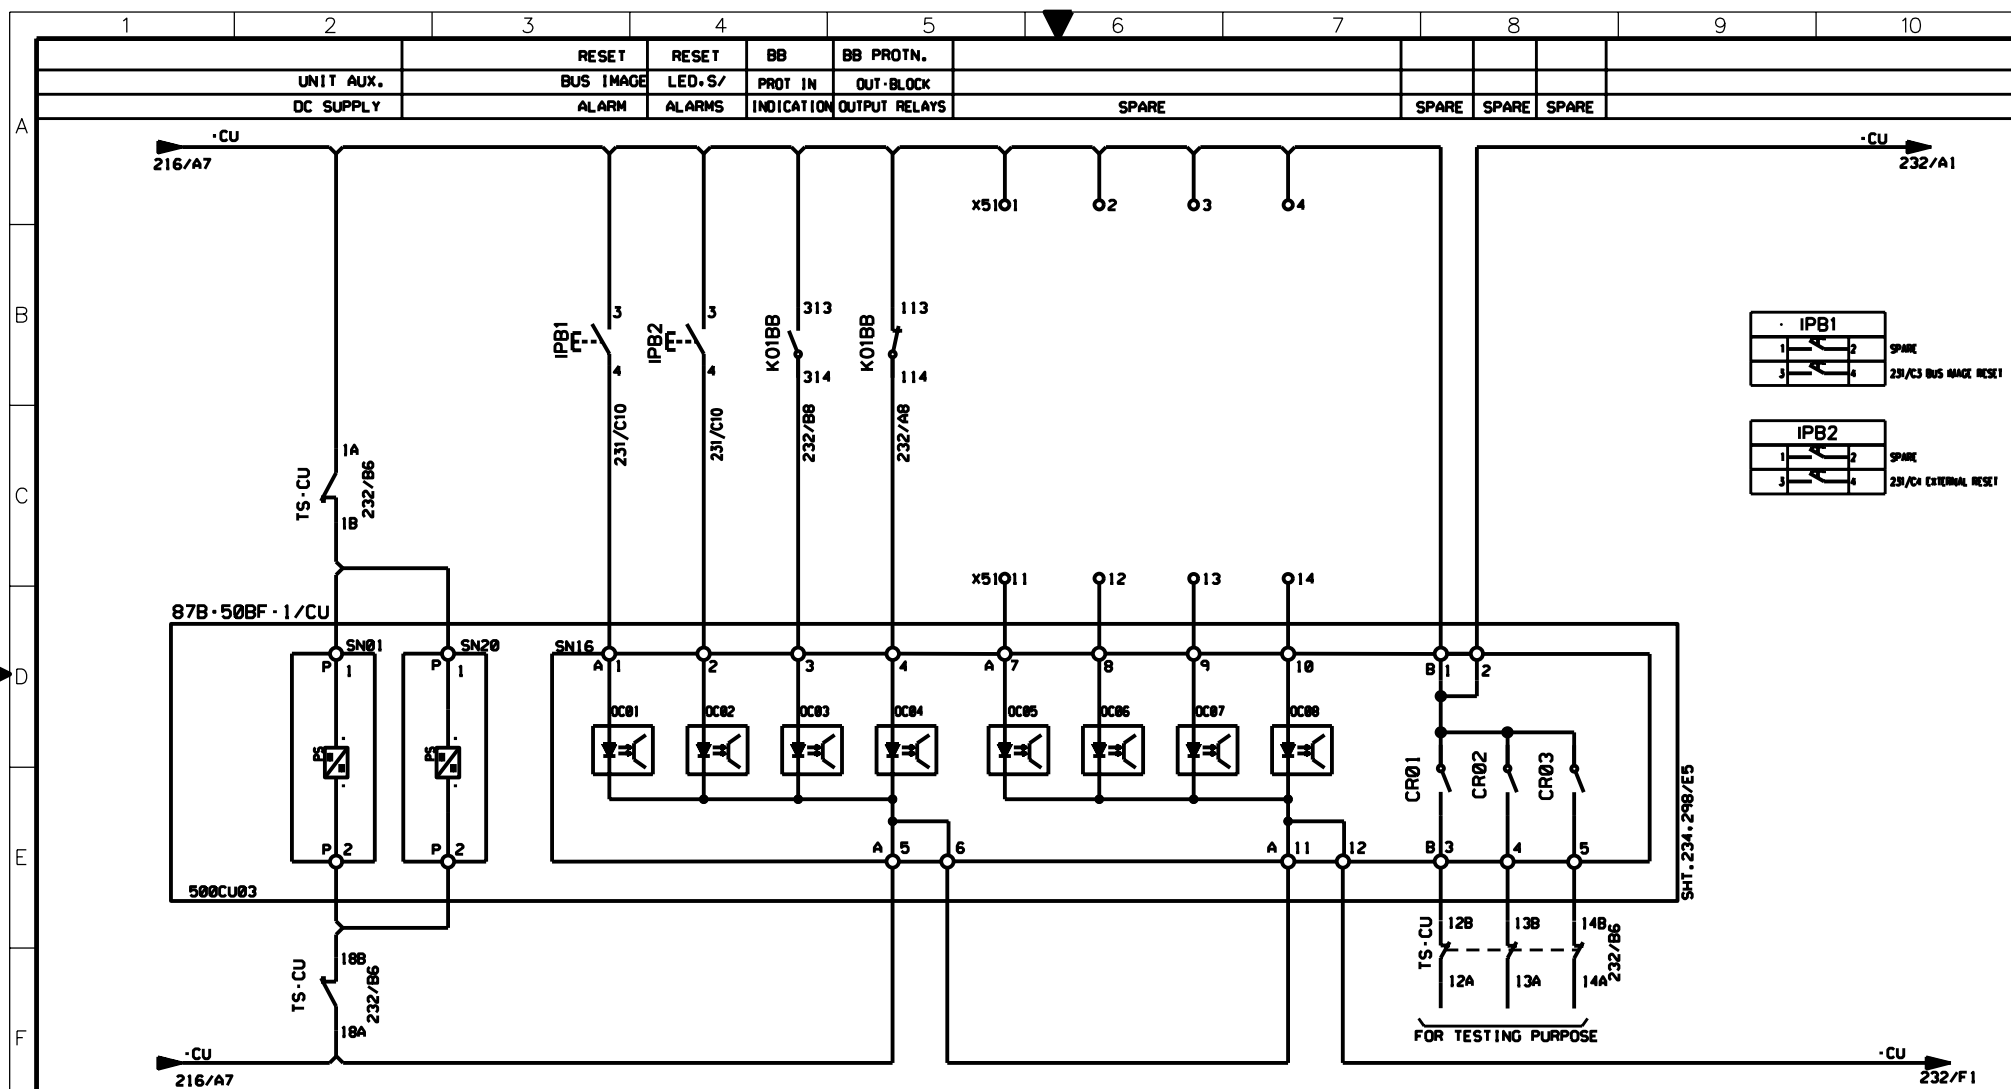


AS-BUILT BY _____ DATE _____ CONTRACT NO. **11131113/00** JOB ORDER NO. **S-13656**

01	13 49	FACTORY ASBUILT
00	13 04	FOR APPROVAL
REV. NO.	DATE	DESCRIPTION

DRAWN BY **RIZ** CHECKED BY **KVR**
 DATE STARTED **24.01.2013** DATE COMPLETED _____
 OPRG. DEPT. **CTPD** ENG. DEPT. **AUT-PSAC**

87B-50BF-1/CU PROTECTION RELAY - BINARY INPUTS
132KV BUSBAR PROT.N.MAIN-1 CU PANEL +BBP1-1
S/S 8709 - 132/13.8KV IN AL-KHARJ CITY
RIYADH SAUDI ARABIA

الشركة الوطنية لنقل الكهرباء		نقل الكهرباء	
National Grid SA		National Grid SA	
INDEX	PLANT NO.	DRAWING NUMBER	SHEET NO.
-	C421	CD-322991	231 232
			REV. NO.
			01

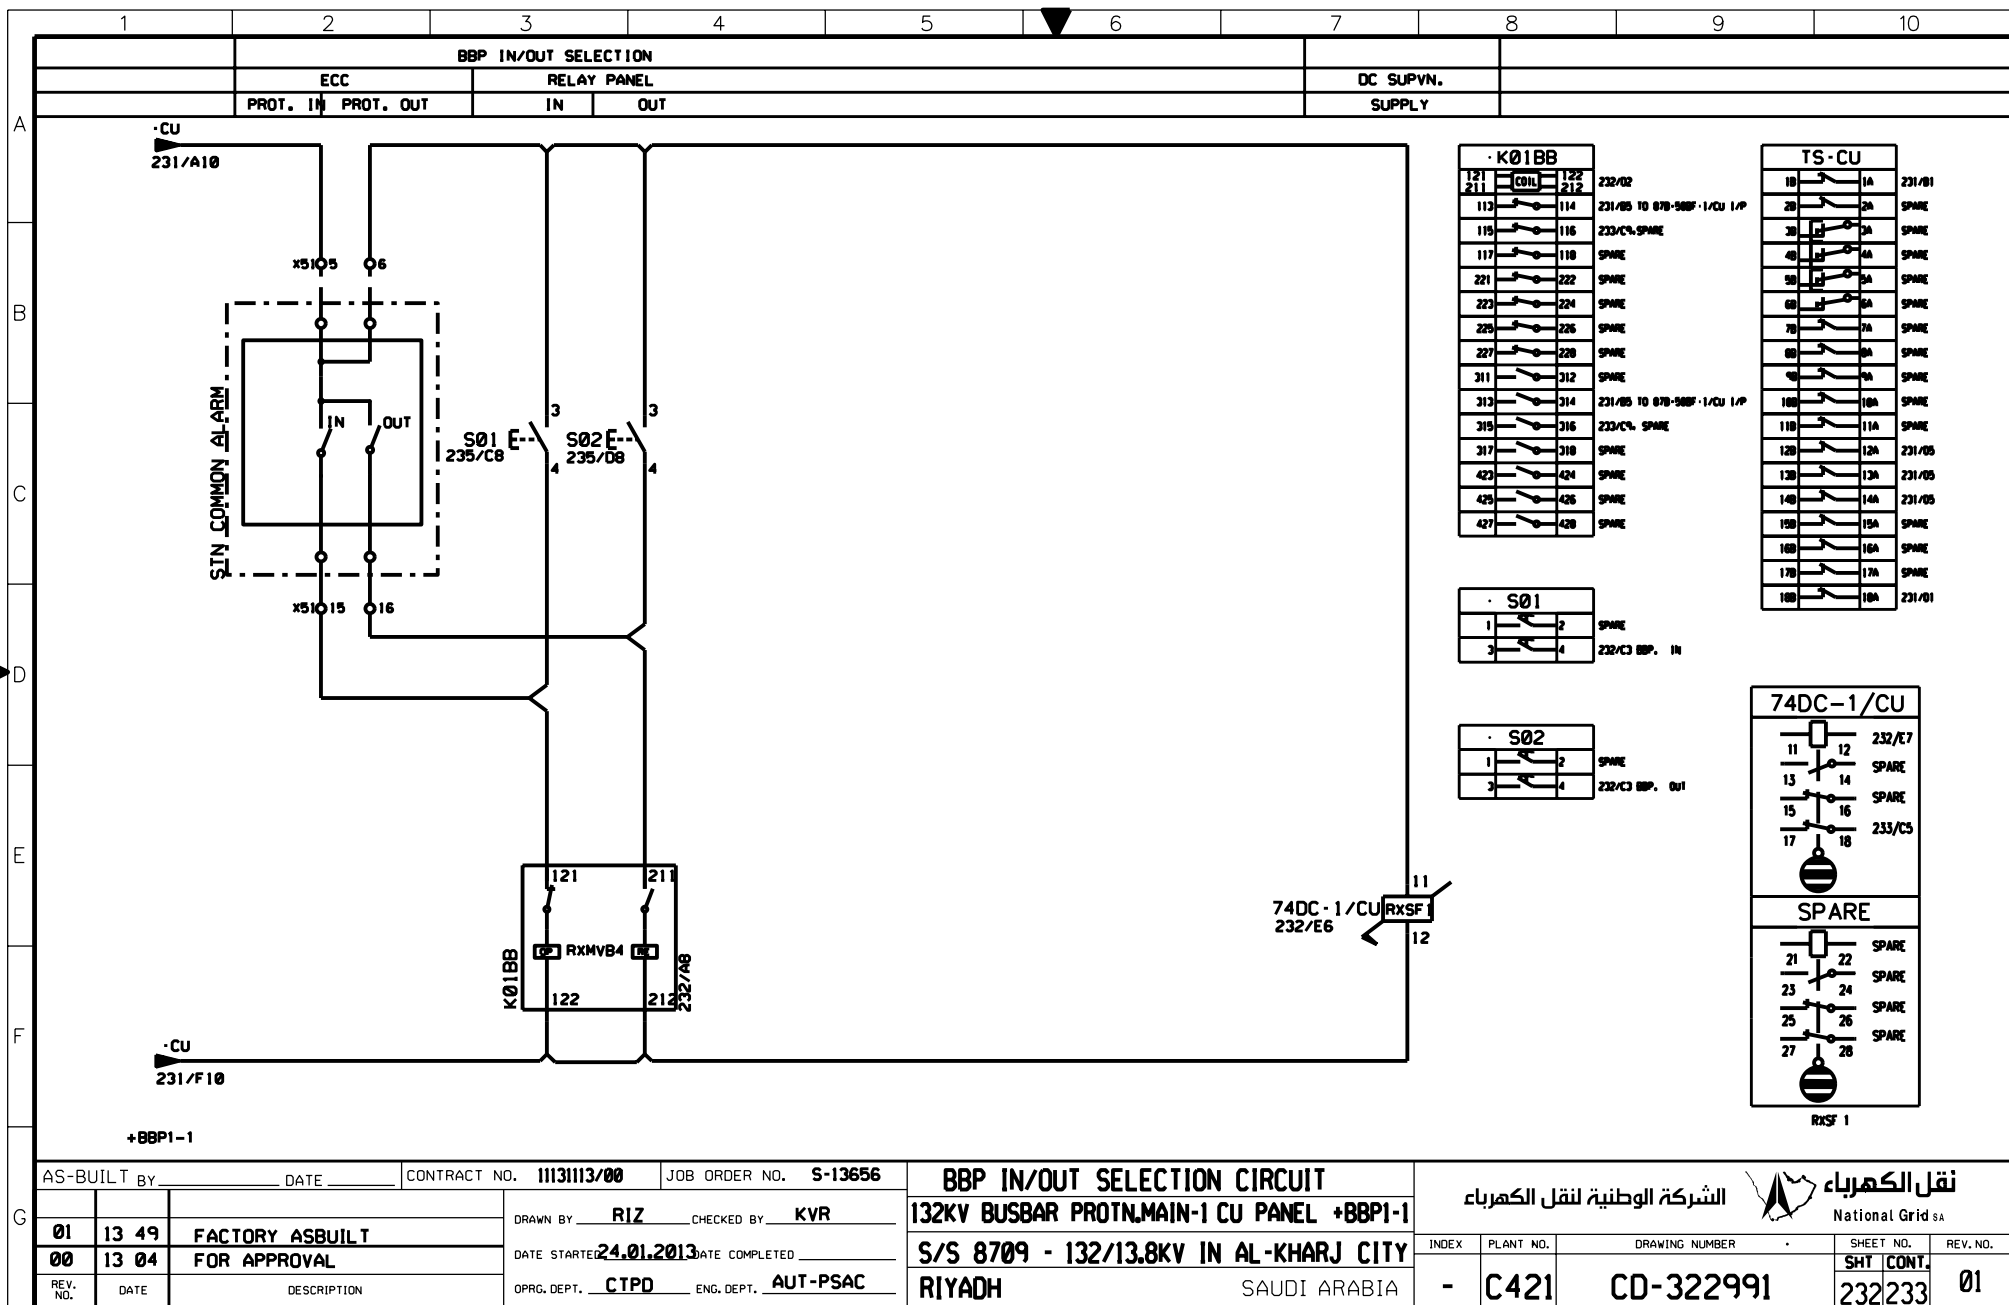

AS-BUILT BY _____ DATE _____ CONTRACT NO. **1113113/00** JOB ORDER NO. **S-13656**

01	13 49	FACTORY ASBUILT	DRAWN BY RIZ CHECKED BY KVR
00	13 04	FOR APPROVAL	DATE STARTED 24.01.2013 DATE COMPLETED _____
REV. NO.	DATE	DESCRIPTION	OPRG. DEPT. CTPD ENG. DEPT. AUT-PSAC

BBP IN/OUT SELECTION CIRCUIT

132KV BUSBAR PROTN.MAIN-1 CU PANEL +BBP1-1


S/S 8709 - 132/13.8KV IN AL-KHARJ CITY


RIYADH SAUDI ARABIA


الشركة الوطنية لنقل الكهرباء



INDEX	PLANT NO.	DRAWING NUMBER	SHEET NO.	REV. NO.
-	C421	CD-322991	SHT 233	01

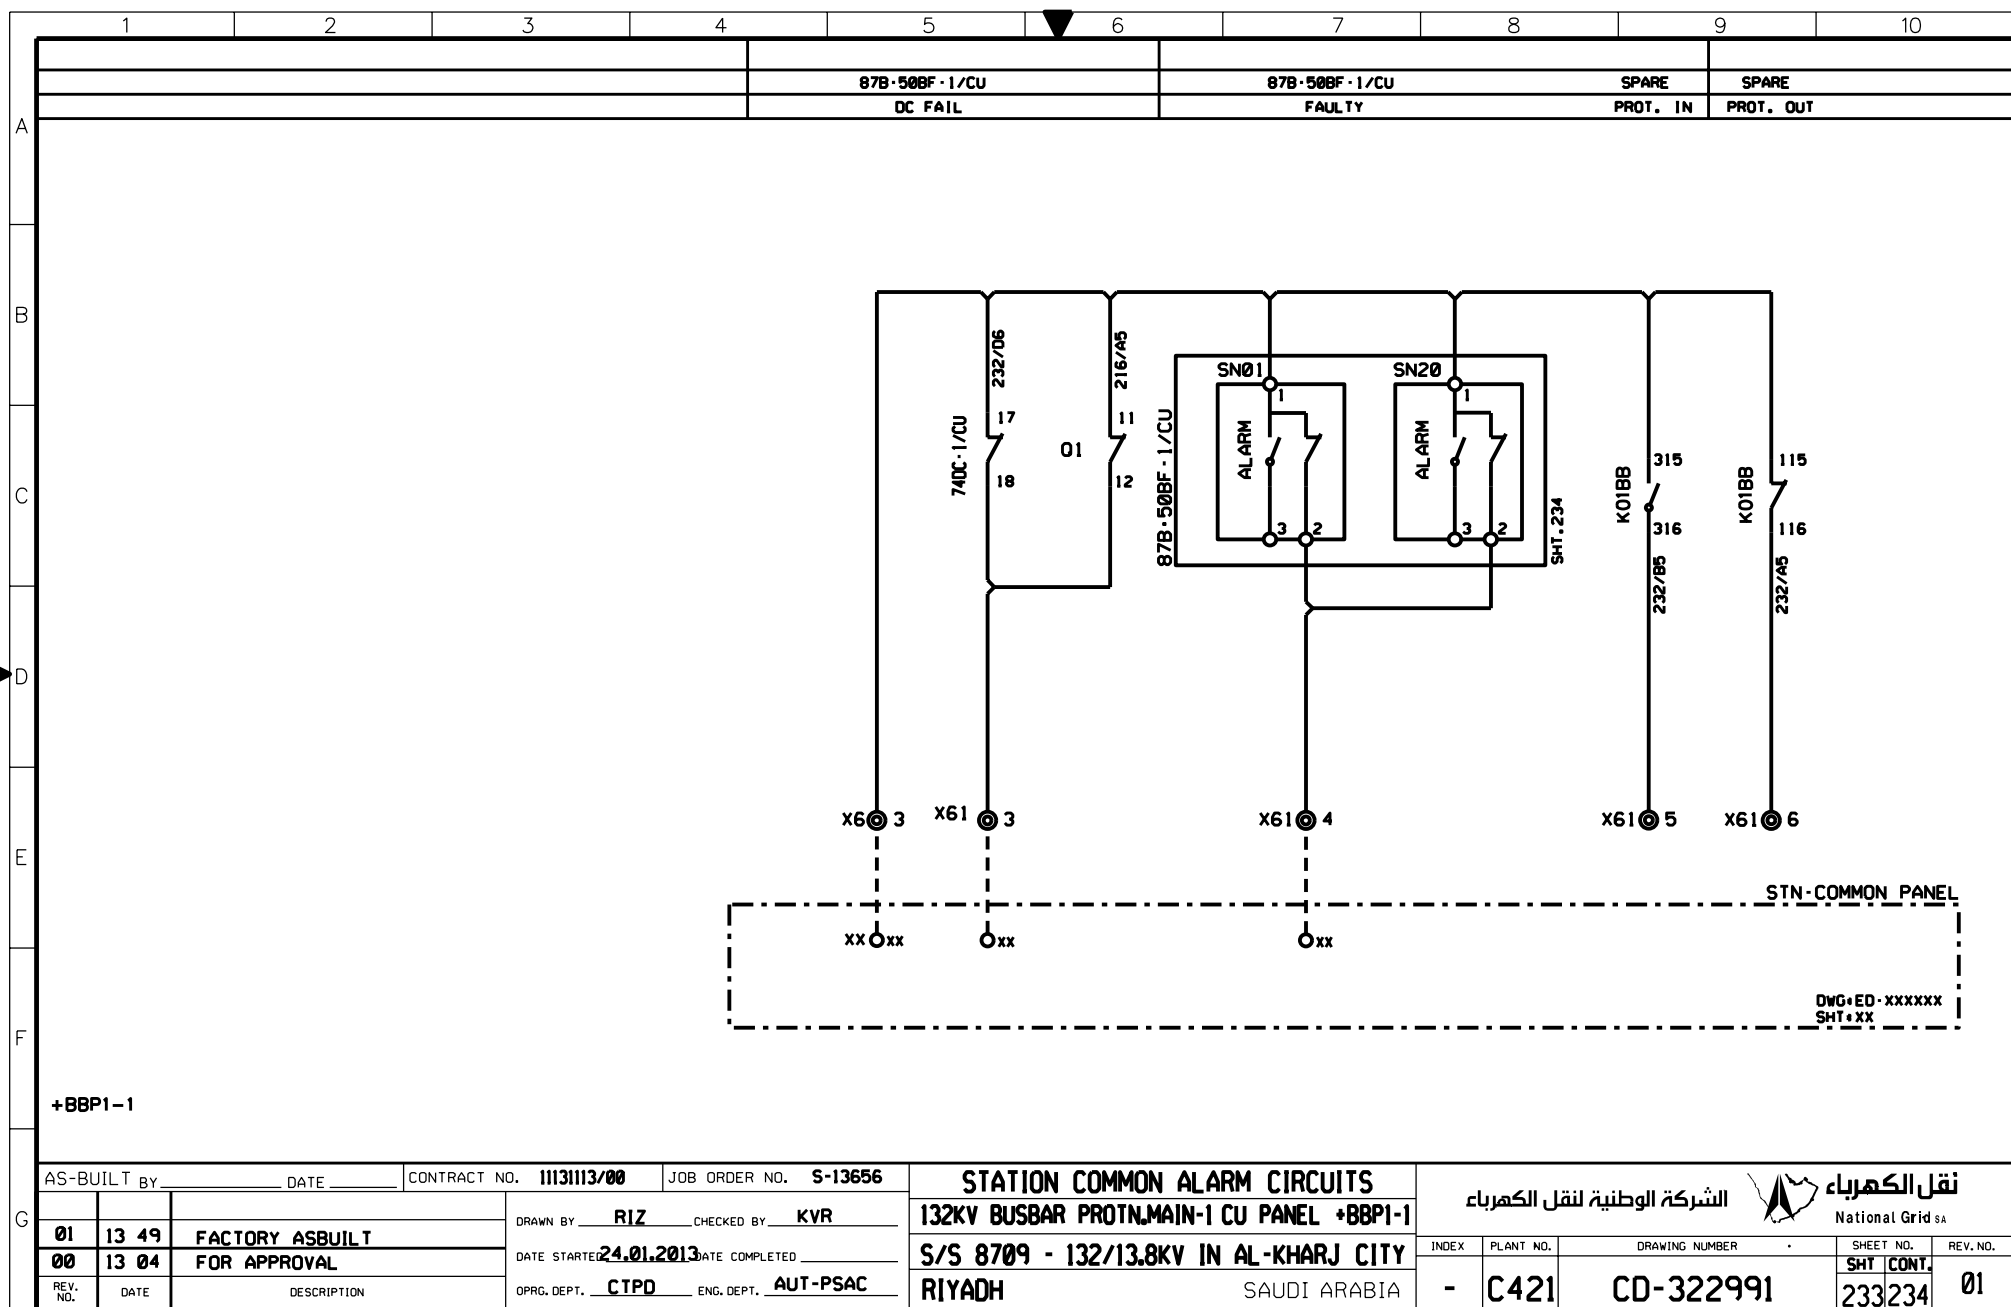

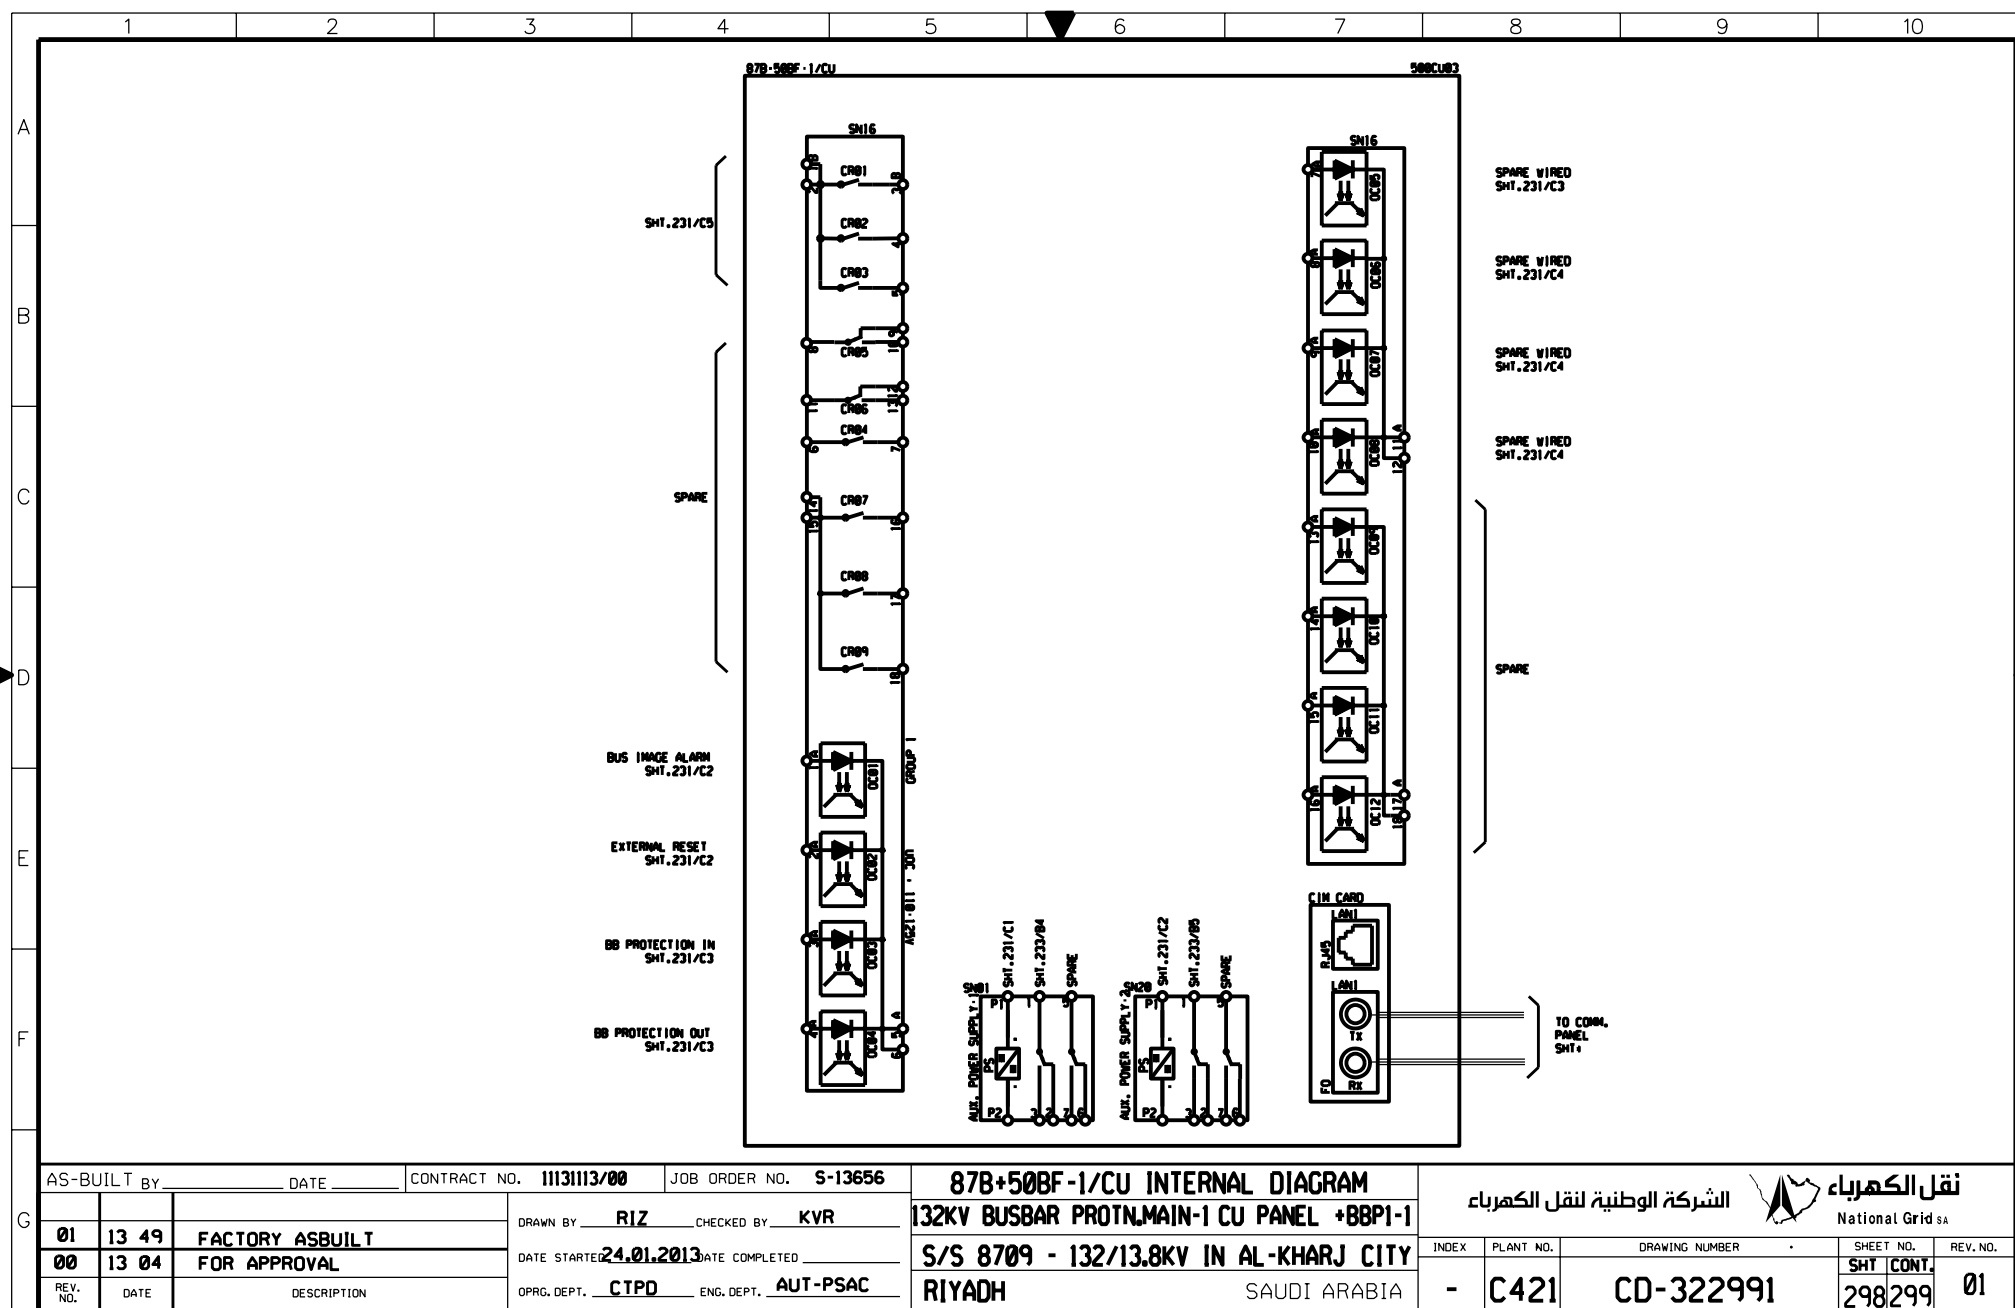

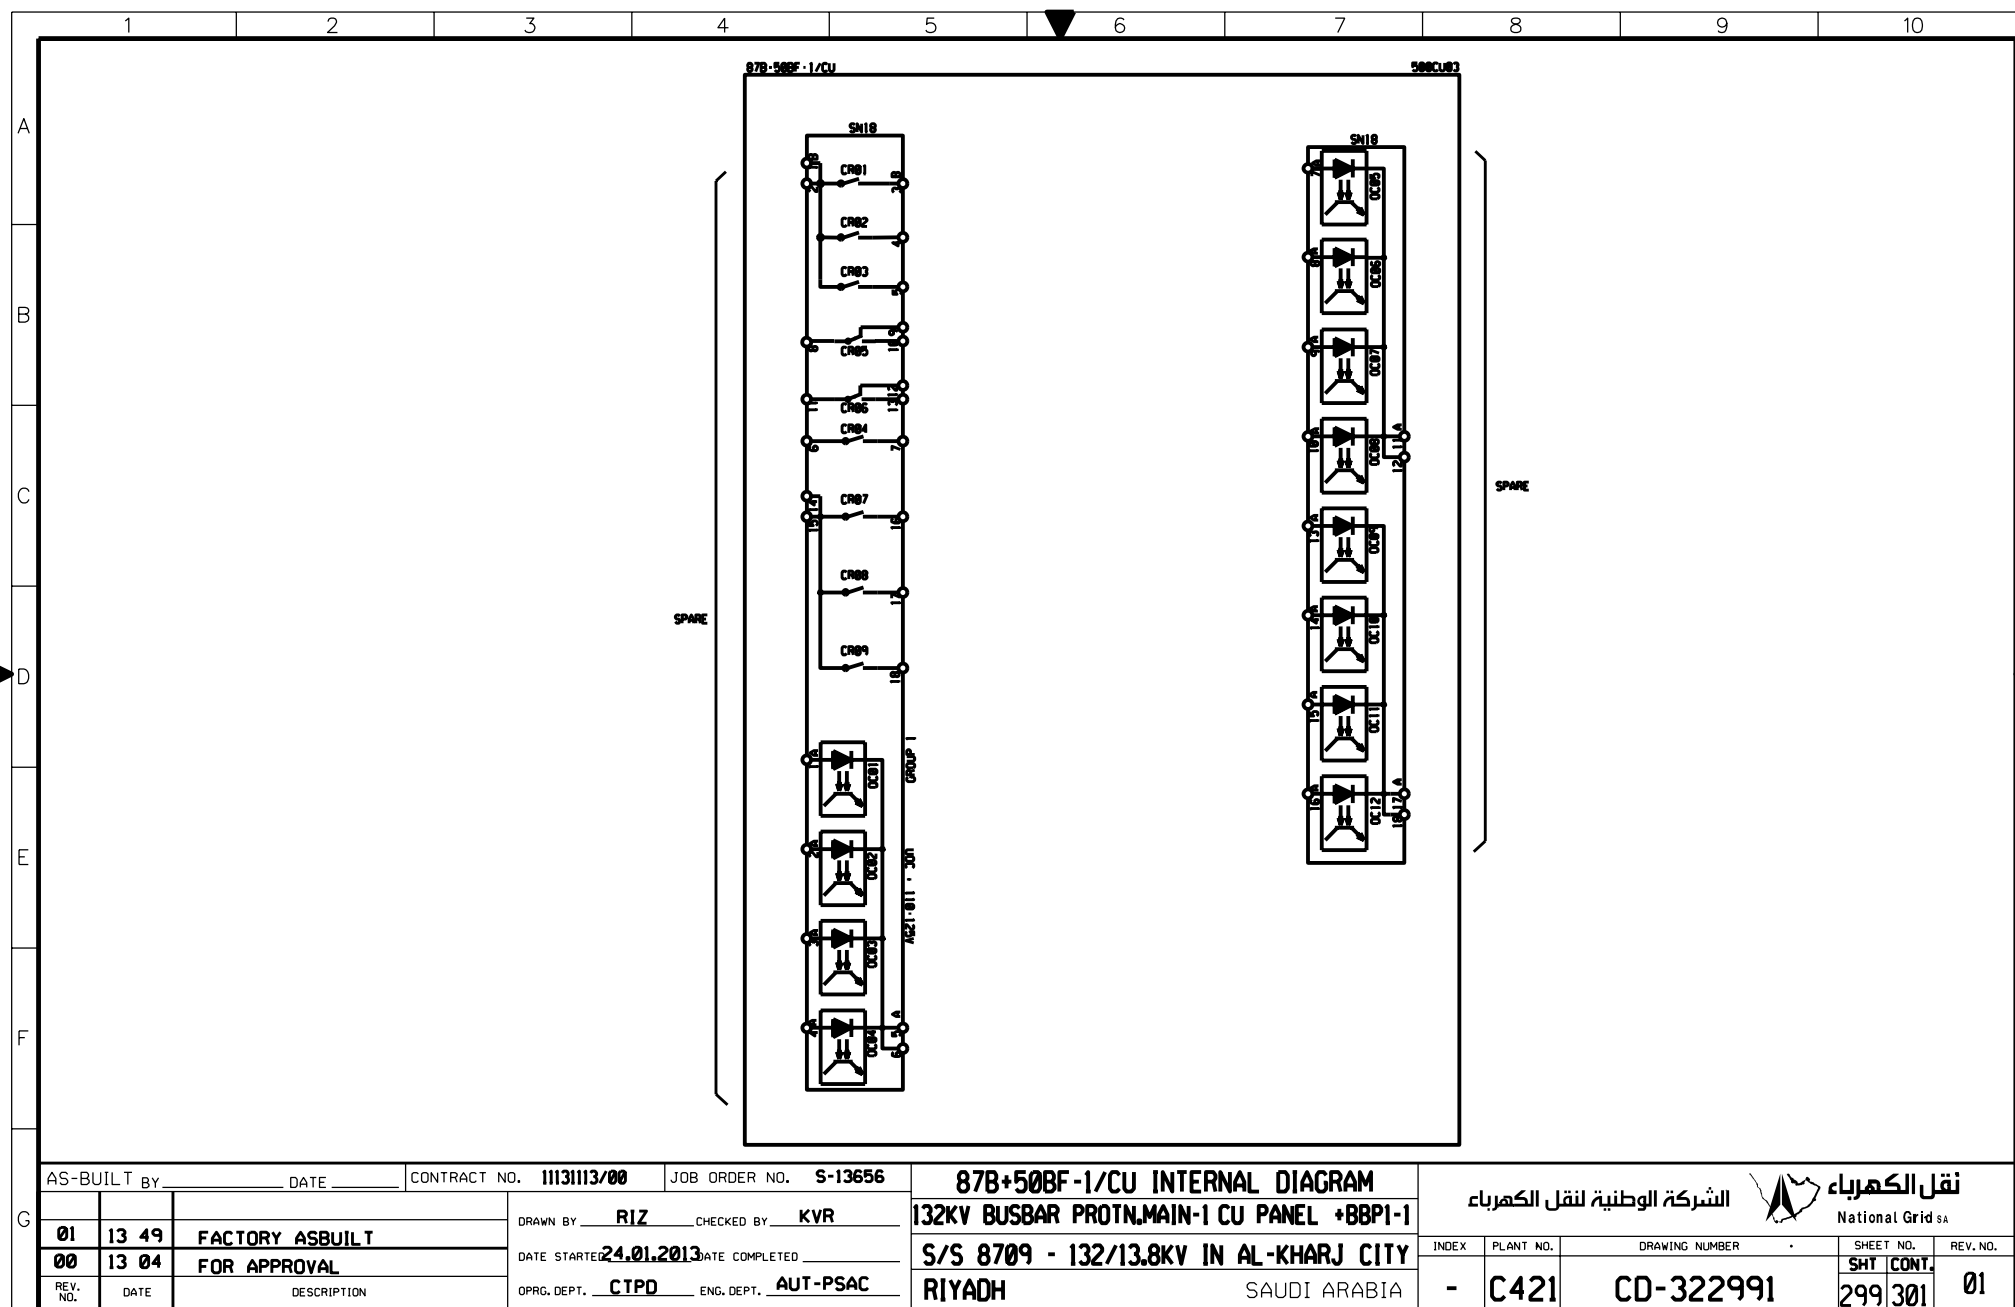

	1	2	3	4	5	6	7	8	9	10																																																																																								
A	<table border="1" style="width:100%; border-collapse: collapse;"> <tr> <td style="width:15%;">INTERNAL REFERENCE</td> <td style="width:15%;">X3 AC CKT.</td> <td style="width:15%;">INTERNAL REFERENCE</td> <td style="width:15%;">X4 DC CKTS</td> <td style="width:15%;">INTERNAL REFERENCE</td> <td style="width:15%;">X5 CONTROL & PROT.</td> <td style="width:15%;">INTERNAL REFERENCE</td> <td style="width:15%;">X61 ALARM CKTS</td> </tr> <tr><td>211/A2</td><td>1</td><td>216/A3</td><td>1</td><td>231/A5</td><td>1</td><td>212/E5</td><td>1</td></tr> <tr><td>211/A5</td><td>2</td><td>216/C3</td><td>2</td><td>231/A6</td><td>2</td><td>212/E6</td><td>2</td></tr> <tr><td>211/A2</td><td>3</td><td>216/D3</td><td>3</td><td>231/A6</td><td>3</td><td>233/E5</td><td>3</td></tr> <tr><td>211/A5</td><td>4</td><td>216/E3</td><td>4</td><td>231/A7</td><td>4</td><td>233/E5</td><td>4</td></tr> <tr><td>211/A2</td><td>5</td><td>216/A3</td><td>5</td><td>232/B2</td><td>5</td><td>233/E7</td><td>5</td></tr> <tr><td>211/A5</td><td>6</td><td>216/C3</td><td>6</td><td>232/B2</td><td>6</td><td>233/E9</td><td>6</td></tr> <tr><td>211/A2</td><td>7</td><td>SPARE</td><td>7</td><td>SPARE</td><td>7</td><td>233/E9</td><td>7</td></tr> <tr><td>211/A5</td><td>8</td><td>SPARE</td><td>8</td><td>SPARE</td><td>8</td><td>SPARE</td><td>8</td></tr> <tr><td>SPARE</td><td>9</td><td>SPARE</td><td>9</td><td>SPARE</td><td>9</td><td>SPARE</td><td>9</td></tr> <tr><td>SPARE</td><td>10</td><td>SPARE</td><td>10</td><td>SPARE</td><td>10</td><td>SPARE</td><td>10</td></tr> </table>										INTERNAL REFERENCE	X3 AC CKT.	INTERNAL REFERENCE	X4 DC CKTS	INTERNAL REFERENCE	X5 CONTROL & PROT.	INTERNAL REFERENCE	X61 ALARM CKTS	211/A2	1	216/A3	1	231/A5	1	212/E5	1	211/A5	2	216/C3	2	231/A6	2	212/E6	2	211/A2	3	216/D3	3	231/A6	3	233/E5	3	211/A5	4	216/E3	4	231/A7	4	233/E5	4	211/A2	5	216/A3	5	232/B2	5	233/E7	5	211/A5	6	216/C3	6	232/B2	6	233/E9	6	211/A2	7	SPARE	7	SPARE	7	233/E9	7	211/A5	8	SPARE	8	SPARE	8	SPARE	8	SPARE	9	SPARE	9	SPARE	9	SPARE	9	SPARE	10	SPARE	10	SPARE	10	SPARE	10
INTERNAL REFERENCE	X3 AC CKT.	INTERNAL REFERENCE	X4 DC CKTS	INTERNAL REFERENCE	X5 CONTROL & PROT.	INTERNAL REFERENCE	X61 ALARM CKTS																																																																																											
211/A2	1	216/A3	1	231/A5	1	212/E5	1																																																																																											
211/A5	2	216/C3	2	231/A6	2	212/E6	2																																																																																											
211/A2	3	216/D3	3	231/A6	3	233/E5	3																																																																																											
211/A5	4	216/E3	4	231/A7	4	233/E5	4																																																																																											
211/A2	5	216/A3	5	232/B2	5	233/E7	5																																																																																											
211/A5	6	216/C3	6	232/B2	6	233/E9	6																																																																																											
211/A2	7	SPARE	7	SPARE	7	233/E9	7																																																																																											
211/A5	8	SPARE	8	SPARE	8	SPARE	8																																																																																											
SPARE	9	SPARE	9	SPARE	9	SPARE	9																																																																																											
SPARE	10	SPARE	10	SPARE	10	SPARE	10																																																																																											
B																																																																																																		
C	<table border="1" style="width:100%; border-collapse: collapse;"> <tr> <td style="width:15%;">INTERNAL REFERENCE</td> <td style="width:15%;">XTJ T. JACK</td> </tr> <tr><td>211/B2</td><td>1</td></tr> <tr><td>211/B2</td><td>2</td></tr> <tr><td>211/B2</td><td>3</td></tr> <tr><td>211/B2</td><td>4</td></tr> <tr><td>SPARE</td><td>5</td></tr> </table>										INTERNAL REFERENCE	XTJ T. JACK	211/B2	1	211/B2	2	211/B2	3	211/B2	4	SPARE	5																																																																												
INTERNAL REFERENCE	XTJ T. JACK																																																																																																	
211/B2	1																																																																																																	
211/B2	2																																																																																																	
211/B2	3																																																																																																	
211/B2	4																																																																																																	
SPARE	5																																																																																																	
D	<table border="1" style="width:100%; border-collapse: collapse;"> <tr> <td style="width:15%;">INTERNAL REFERENCE</td> <td style="width:15%;">XSH SPACEHEATER</td> </tr> <tr><td>211/E7</td><td>1</td></tr> <tr><td>211/F7</td><td>2</td></tr> <tr><td>SPARE</td><td>3</td></tr> <tr><td>SPARE</td><td>4</td></tr> <tr><td>SPARE</td><td>5</td></tr> </table>										INTERNAL REFERENCE	XSH SPACEHEATER	211/E7	1	211/F7	2	SPARE	3	SPARE	4	SPARE	5																																																																												
INTERNAL REFERENCE	XSH SPACEHEATER																																																																																																	
211/E7	1																																																																																																	
211/F7	2																																																																																																	
SPARE	3																																																																																																	
SPARE	4																																																																																																	
SPARE	5																																																																																																	
E	<table border="1" style="width:100%; border-collapse: collapse;"> <tr> <td style="width:15%;">INTERNAL REFERENCE</td> <td style="width:15%;">X6 ALARM CKTS</td> </tr> <tr><td>212/B5</td><td>1</td></tr> <tr><td>212/B5</td><td>2</td></tr> <tr><td>SPARE</td><td>3</td></tr> <tr><td>SPARE</td><td>4</td></tr> <tr><td>SPARE</td><td>5</td></tr> </table>										INTERNAL REFERENCE	X6 ALARM CKTS	212/B5	1	212/B5	2	SPARE	3	SPARE	4	SPARE	5																																																																												
INTERNAL REFERENCE	X6 ALARM CKTS																																																																																																	
212/B5	1																																																																																																	
212/B5	2																																																																																																	
SPARE	3																																																																																																	
SPARE	4																																																																																																	
SPARE	5																																																																																																	
F																																																																																																		

AS-BUILT BY _____ DATE _____		CONTRACT NO. 11131113/00	JOB ORDER NO. S-13656	TERMINAL BLOCK ALLOCATION		نقل الكهرباء الشركة الوطنية لنقل الكهرباء National Grid sa	
DRAWN BY RIZ CHECKED BY KVR		DATE STARTED 24.01.2013 DATE COMPLETED _____		132KV BUSBAR PROTN.MAIN-1 CU PANEL +88P1-I		INDEX	
DATE STARTED 24.01.2013 DATE COMPLETED _____		OPRG. DEPT. CTPD ENG. DEPT. AUT-PSAC		S/S 8709 - 132/13.8KV IN AL-KHARJ CITY		PLANT NO.	
REV. NO. _____ DATE _____ DESCRIPTION _____				RIYADH		DRAWING NUMBER	
				SAUDI ARABIA		- C421	
				CD-322991		SHEET NO.	
				301		CONT.	
				01		REV. NO.	
				01		NG/D2-D (2012/01)	
				NGD200		VECTOR	

THIS DRAWING AND THE INFORMATION CONTAINED HEREIN ARE THE SOLE PROPERTY OF NGD. NO REPRODUCTION IN FULL OR IN PART SHALL BE OBTAINED FROM THIS DOCUMENT WITHOUT THE WRITTEN CONSENT OF ITS OWNER.